


FIRST FLOOR

CAVENDISHPLACE

CAVENDISHSQUARE

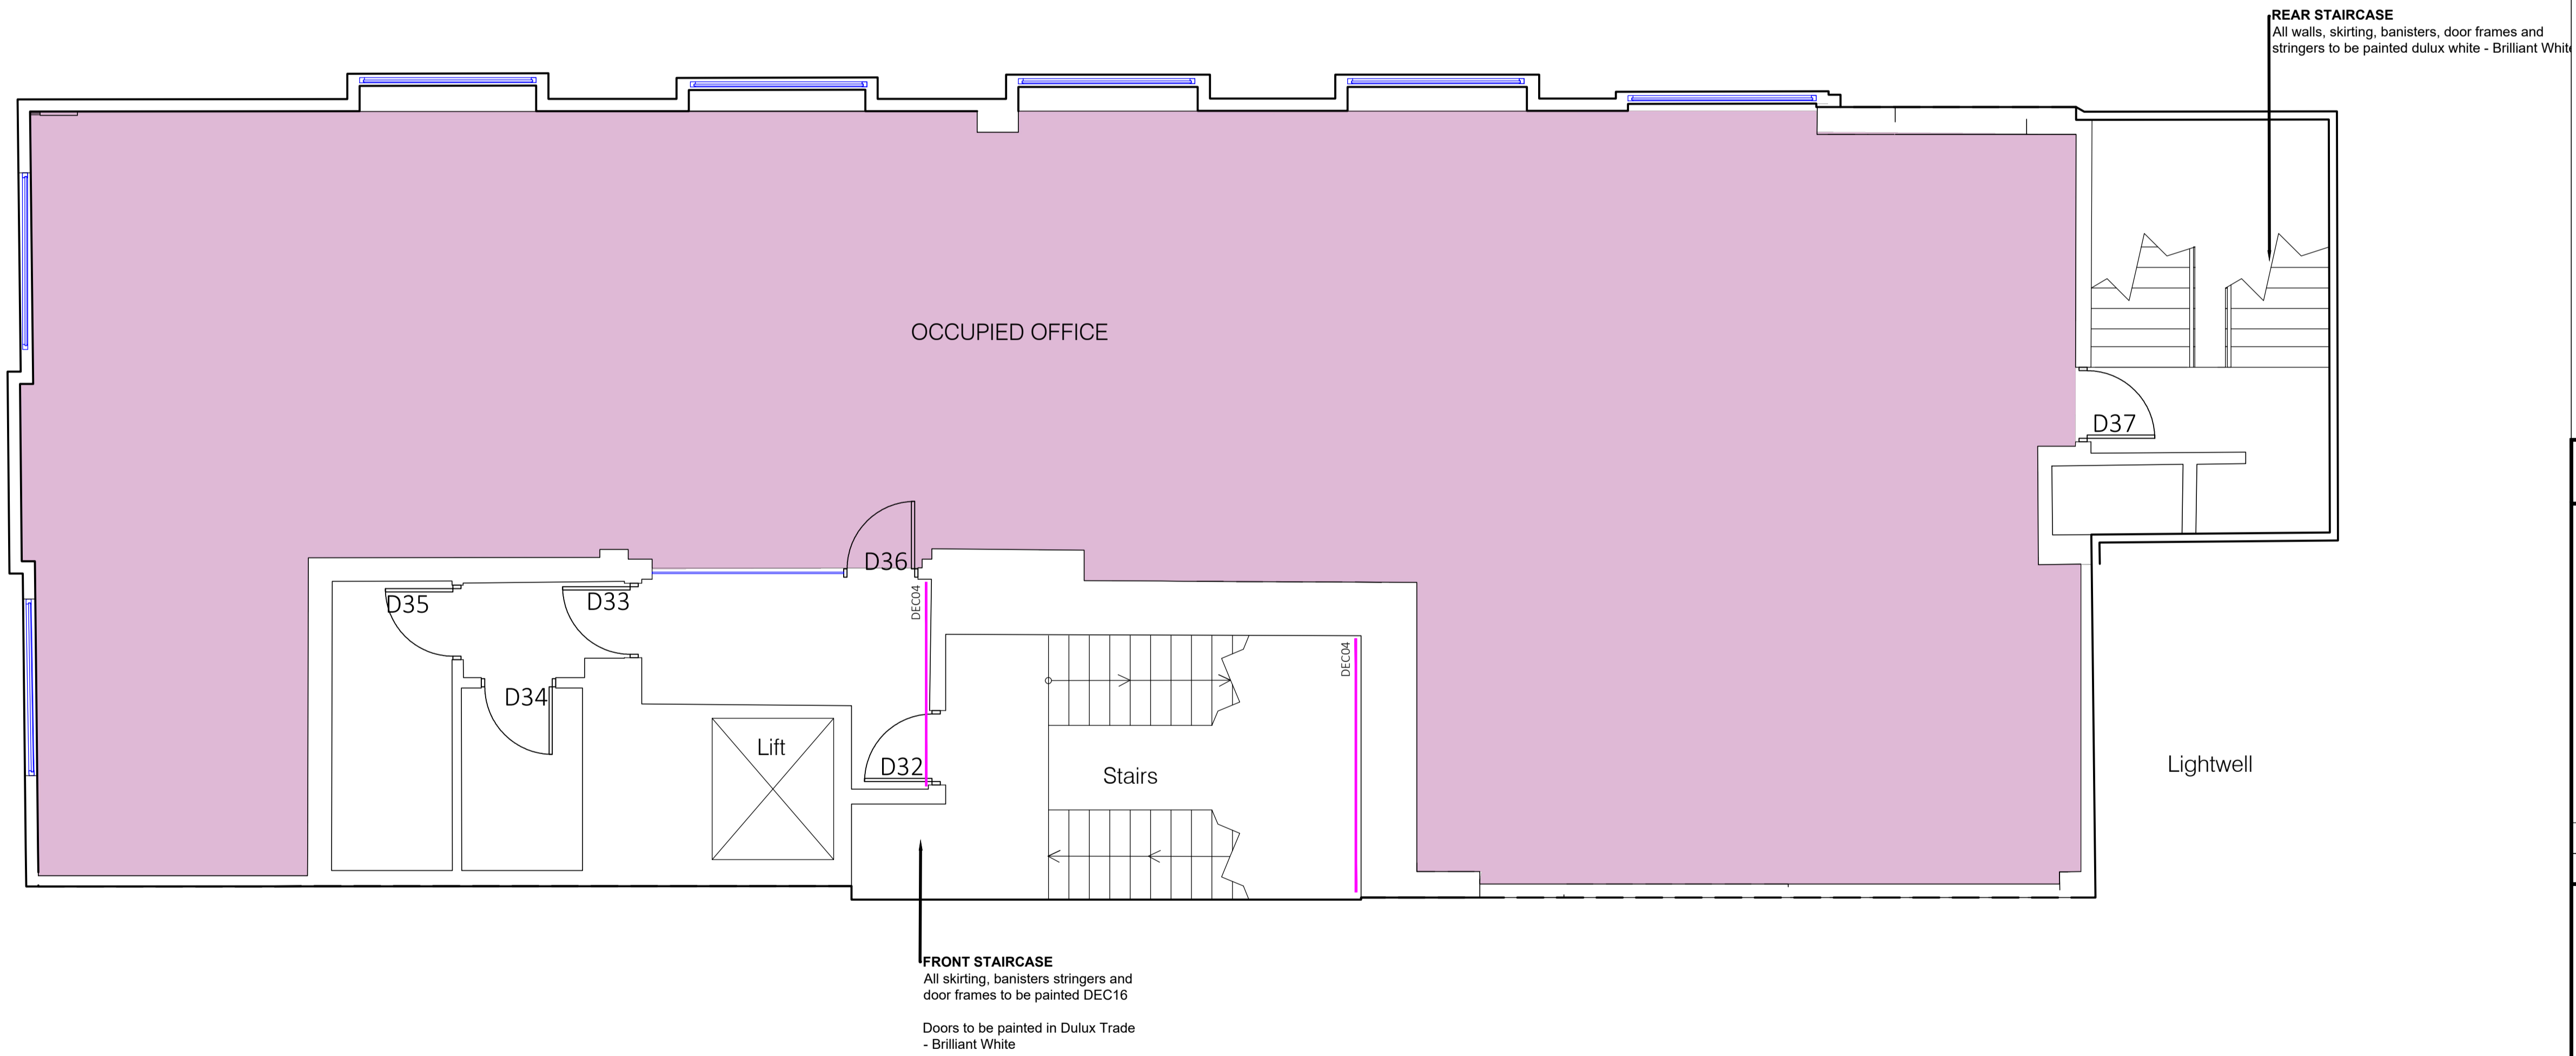

This drawing may not be copied, reproduced or given to any third parties for any reason whatsoever without the written permission of Loop Interiors International Ltd. Please note this drawing and design is protected under Copyright and remains the property of Loop Interiors International Ltd at all times. Proposals are subject to approval by statutory authorities.
© Copyright 2022 Loop Interiors International Ltd

Standard Instructions

A: All dimensions to be verified on site & any discrepancies on the drawings or divergence between drawings to be immediately reported to the Project Manager before putting the work concerned in hand, fabricating the work or preparing shop drawings.
B: Work to figured dimensions only (except where full size details are provided).
C: Do not vary any work shown on the drawings without obtaining prior approval from the Project Manager or Designer.
D: Any additional information required should be requested from the Project Manager or Designer before commencement of work on site.

FOR COMMENT	
A: APPROVED	<input type="checkbox"/>
B: APPROVED WITH COMMENT	<input type="checkbox"/>
C: INFORMATION	<input type="checkbox"/>
D: CONSTRUCTION	<input type="checkbox"/>
E: AS BUILT	<input type="checkbox"/>

CLIENT SIGNATURE: _____

- WALL FINISHES KEY**
- UNLESS OTHERWISE STATED, NEW WALLS, SKIRTING, RISER DOORS AND FRAMES, AND WINDOW SILLS TO BE DECORATED WITH DULUX TRADE - BRILLIANT WHITE
- DEC01 - Feature Decoration - Navy Blue
Supplier: COAT Paints
Ref/Code: Zam
 - DEC02 - Joinery Panelling - (J05)
Supplier: TBC
Ref/Code: Half height panelling - bespoke design
 - DEC03 - Wallcovering
Supplier: Tektura
Ref/Code: House of Tweed HOU10
 - DEC04 - Wallcovering
Supplier: Tektura
Ref/Code: Angles Max ANG47608 (Stairs)
 - DEC05 - Wallcovering
Supplier: Tektura
Ref/Code: Angles Max ANG47605 (Offices)
 - DEC06 - Feature Decoration - Sage
Supplier: Dulux Trade
Ref/Code: Common Land 500Y 57/096
 - DEC07 - Feature Decoration - Pale Pink
Supplier: Dulux Trade
Ref/Code: Sweet Nougat 09YR 6J/117
 - DEC08 - Wallcovering
Supplier: Tektura
Ref/Code: Angles Max ANG47617
 - DEC09 - Feature Decoration - Orange
Supplier: Dulux Trade
Ref/Code: Notebook Orange 70YR 27/404
 - DEC10 - No longer in scope
 - DEC11 - Wall Tiles - Blue
Supplier: Porcelain Superstore
Ref/Code: Dwell Cobalt Tile
 - DEC12 - Wall Tiles - White
Supplier: Porcelain Superstore
Ref/Code: Dwell White Tile
 - DEC13 & 14 - Refer to Teapoint Drawing
 - DEC15 - Geometric Slat (Bespoke Design) (J07 & J08)
Supplier: Bespoke - tbc
Ref/Code: Geometric design - painted in Dulux Trade - Common Land 500Y 57/096
 - DEC16 - Feature Decoration
Supplier: Dulux Trade
Ref/Code: Basically Black
- GRAPHICS KEY**
- MAN01 - Chevron Manifestation
Supplier: tbc
Ref/Code: 50% opacity - bespoke window film design - central band across glazing

Ceiling Height	Sill Height	Floor Type
3043	TBC	N/A

Revision	Description	Date	By
AB	As Built	11.03.25	CS



Client Name:
Savills / Spectra Real Estate Limited

Project Address:
8 Cavendish Square, London

Drawing Title:
Decoration - First Floor

Drawing Scale:	Drawn By:	Date Created:
1:50 @ A1	LN	30.05.24

Project Number	Floor Number	Drawing Type	Revision
1581	01	DEC	AB

SCALE BAR 1:50

