


GROUND FLOOR

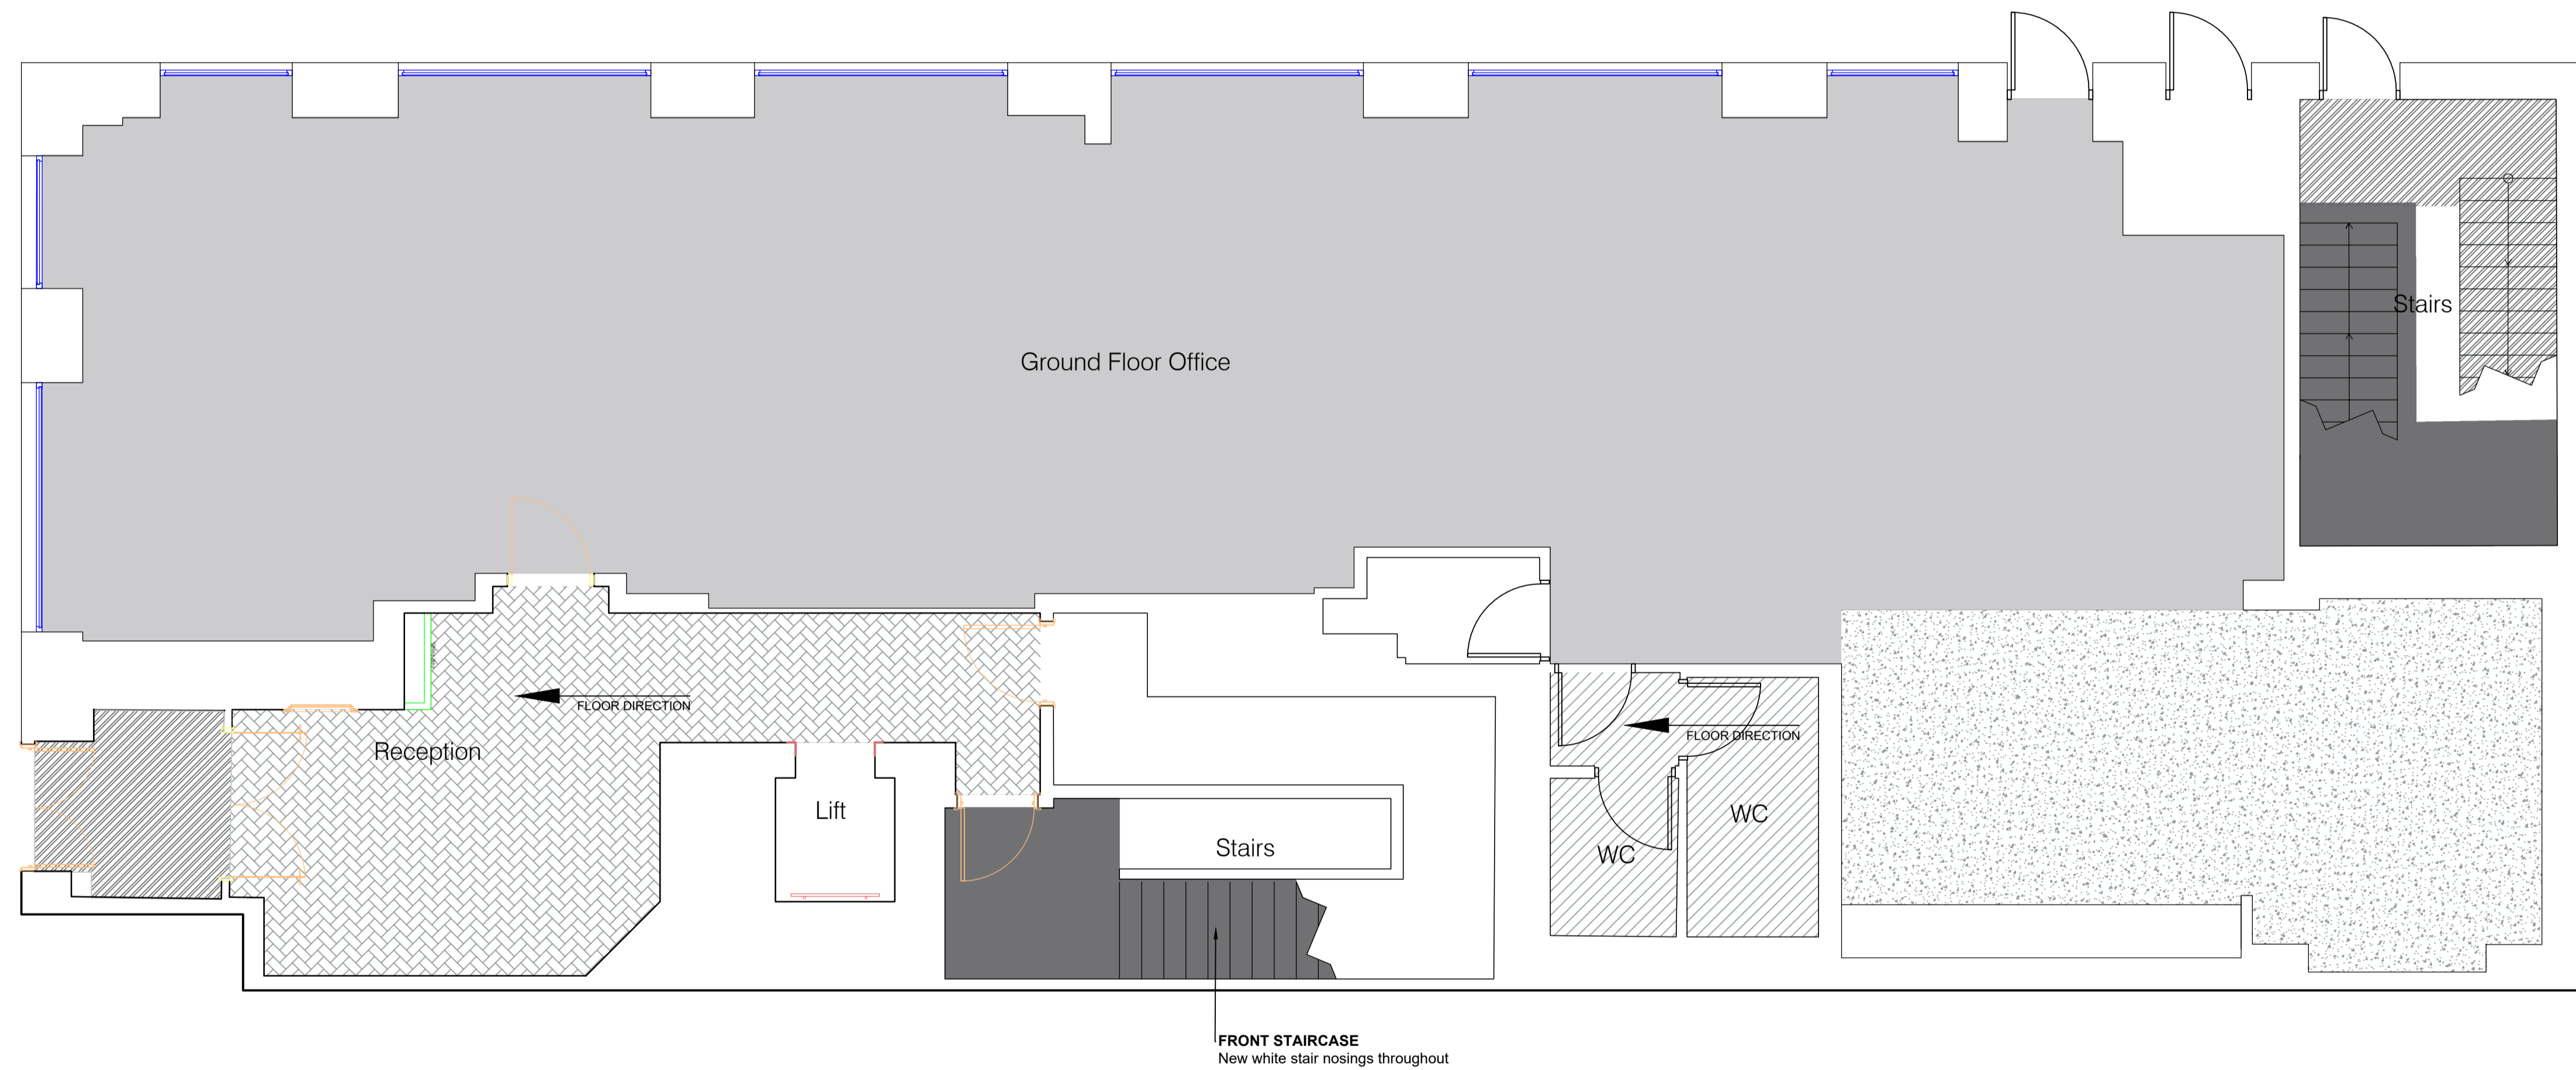

This drawing may not be copied, reproduced or given to any third party for any reason whatsoever without the written permission of Loop Interiors International Ltd. Please note this drawing and design is protected under Copyright and remains the property of Loop Interiors International Ltd at all times. Proposals are subject to approval by statutory authorities.
© Copyright 2022 Loop Interiors International Ltd.

Standard Instructions
 A: All dimensions to be verified on site & any discrepancies on the drawings or divergence between drawings to be immediately reported to the Project Manager before putting the work concerned in hand, fabricating the work or preparing shop drawings.
 B: Work to figured dimensions only (except where full size details are provided).
 C: Do not vary any work shown on the drawings without obtaining prior approval from the Project Manager or Designer.
 D: Any additional information required should be requested from the Project Manager or Designer before commencement of work on site.

FOR COMMENT	
A: APPROVED	<input type="checkbox"/>
B: APPROVED WITH COMMENT	<input type="checkbox"/>
C: INFORMATION	<input type="checkbox"/>
D: CONSTRUCTION	<input type="checkbox"/>
E: AS BUILT	<input type="checkbox"/>

CLIENT SIGNATURE: _____

- FF01 - Entrance Matting**
Supplier: Forbo
Product: Coral Classic
Code: 4730 Raven Black
Install: Sheet
- FF02 - Tiles**
Supplier: Fired Earth
Product: Umbrian White
Size: 30x60cm
Install: Ashlar
w. anti fracture matting
- FF03 - Carpet**
Supplier: Interface
Product: Recreation
Code: 431306 Foundation
Install: Non Directional
- FF04 - NO LONGER IN SCOPE**
- FF05 - Carpet**
Supplier: Interface
Product: Composure
Code: 4169002 Diffuse
Install: Non Directional
- FF06 - Vinyl**
Supplier: Interface
Product: LVT - Fresco Valley
Code: A02403 Limestone
Install: Ashlar
- FF07 - Shear Flooring**
Supplier: Altro
Product: Atlas 40
Code: X4039 Pewter Grey
Install: tbc
- FF08 - Vinyl**
Supplier: Interface
Product: LVT - Textured Woodgrain
Code: A00420 Rustic Cashew
Install: Ashlar
- FF09 - Carpet**
Supplier: Interface
Product: Archival 9949002
Colour: Pearl
Install: Ashlar

Ceiling Height	Sill Height	Floor Type
3043	TBC	N/A

AB	As Built	11.03.25	CS
----	----------	----------	----

Revision	Description	Date	By
----------	-------------	------	----

LOOP LOCAL
7 Borelli Yard, Farnham
GU9 7NU
Tel: +44 (0) 20 3772 6000
www.loopinteriors.com

Client Name:
Savills / Spectra Real Estate Limited

Project Address:
8 Cavendish Square, London

Drawing Title:
Flooring - Ground Floor

Drawing Scale:	Drawn By:	Date Created:
1:50 @ A1	LN	03.01.22

Project Number	Floor Number	Drawing Type	Revision
1581	00	FLR	AB

SCALE BAR 1:50

