


THIRD FLOOR

CAVENDISHPLACE

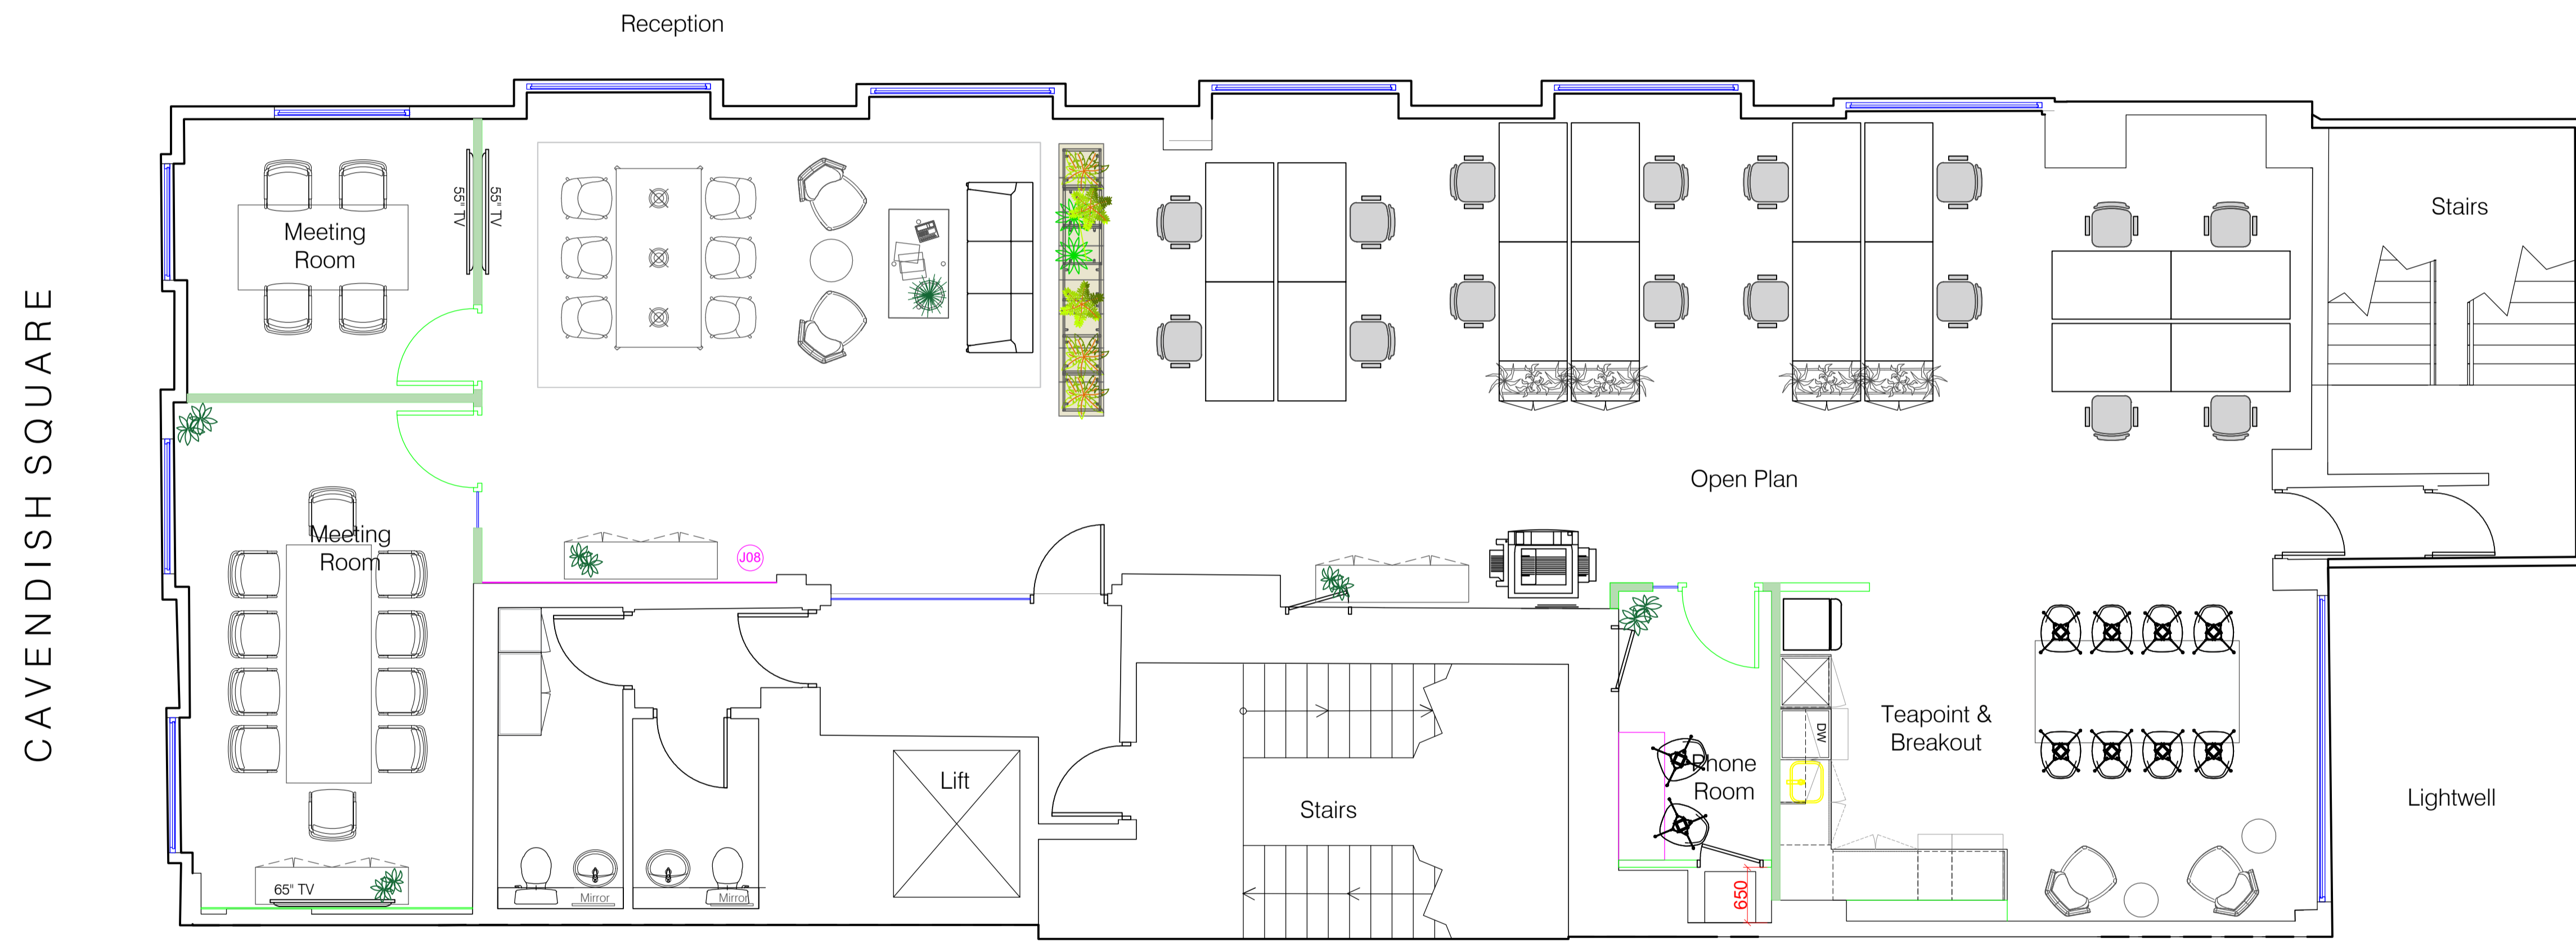

CAVENDISH SQUARE

This drawing may not be copied, reproduced or given to any third parties for any reason whatsoever without the written permission of Loop Interiors International Ltd. Please note this drawing and design is protected under Copyright and remains the property of Loop Interiors International Ltd at all times. Proposals are subject to approval by statutory authorities.
 © Copyright 2022 Loop Interiors International Ltd.

Standard Instructions

A: All dimensions to be verified on site & any discrepancies on the drawings or divergence between drawings to be immediately reported to the Project Manager before putting the work concerned in hand, fabricating the work or preparing shop drawings.
 B: Work to figured dimensions only (except where full size details are provided).
 C: Do not vary any work shown on the drawings without obtaining prior approval from the Project Manager or Designer.
 D: Any additional information required should be requested from the Project Manager or Designer before commencement of work on site.

FOR COMMENT	
A: APPROVED	<input type="checkbox"/>
B: APPROVED WITH COMMENT	<input type="checkbox"/>
C: INFORMATION	<input type="checkbox"/>
D: CONSTRUCTION	<input type="checkbox"/>
E: AS BUILT	<input type="checkbox"/>
CLIENT SIGNATURE: _____	

Ceiling Height	Sill Height	Floor Type
2573	1031	N/A

AB	As Built	11.03.25	CS
Revision	Description	Date	By

LOOP LOCAL
 7 Borell Yard, Farnham
 GU9 7NU
 Tel: +44 (0) 20 3772 6000
 www.loopinteriors.com

Client Name:
Savills / Spectra Real Estate Limited

Project Address:
 8 Cavendish Square, London

Drawing Title:
 General Arrangement - Third Floor

Drawing Scale:	Drawn By:	Date Created:
1:50 @ A1	LN	04.01.23

Project Number	Floor Number	Drawing Type	Revision
1581	03	GA	AB

SCALE BAR 1:50

