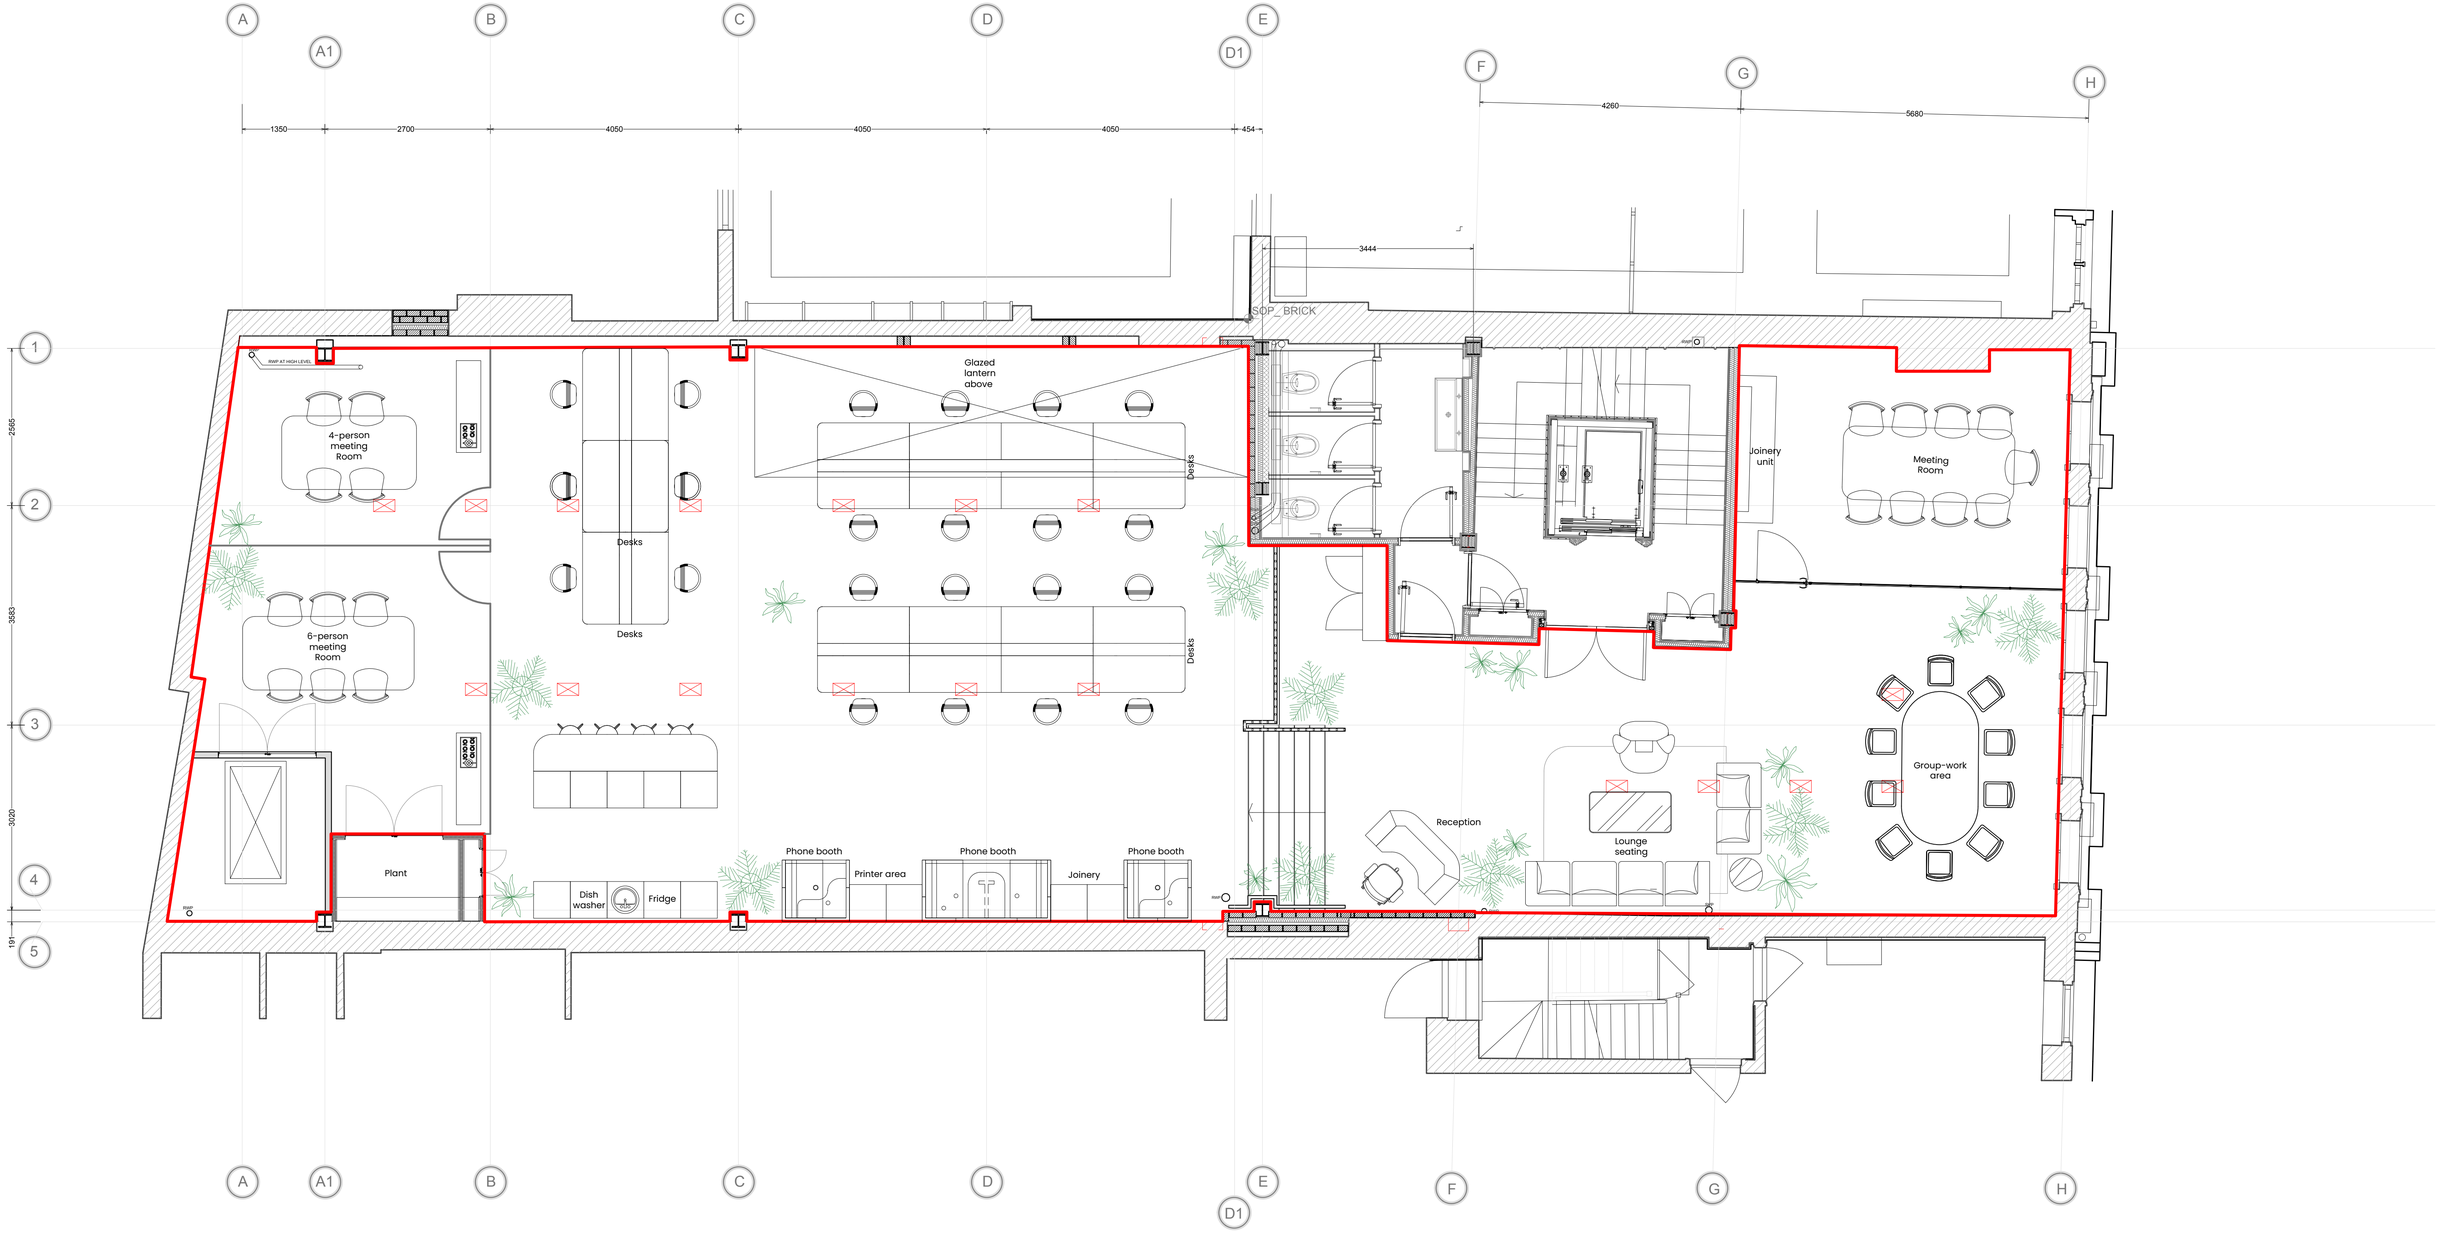


01 First Floor Plan
Scale: 1:50 @A1


General Notes:

1. Do not scale from this drawing. Refer to stated dimensions.
2. All dimensions to be verified on site by the contractor, before proceeding, and such dimensions to be his responsibility.
3. Report all drawing errors, omissions and discrepancies to supernatural studio.
4. All stated areas on this drawing are approximate and to be treated as strictly indicative.
5. Any Ordnance Survey mapping data in this drawing is used under license. Its use is strictly for the preparation of information for this project. Where used Ordnance Survey copyright acknowledgement must be displayed. At project completion, all Ordnance Survey data supplied must be deleted and all paper copies destroyed.

Drawing Issue:

Rev	Date	Reason For Issue	Check
I01	05/06/25	Information	JH
I02	07/09/26	Information	JH
I03	07/09/26	Information	JH

Location:

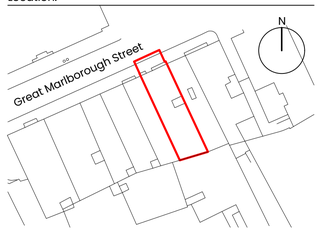

Scale & Key

0 5m

Drawing Notes

This drawing has been prepared using base drawings provided by Morrow + Lorraine to illustrate the interior fit-out changes made since completion. The base drawings reflect the as-built condition as provided by the original architect, and this drawing is for reference purposes only.

The modifications and annotations shown here are limited to the interior fit-out and do not represent any structural, architectural, or building services elements originally designed by Morrow + Lorraine. No warranty is made as to the accuracy or completeness of the base drawings or their compliance with current regulations.

This drawing is not intended for construction, tendering, or detailed design purposes. Any reliance on this document for purposes outside its intended reference use is at the user's own risk.

supernaturalstudio

info@supernaturalstudio.com

www.supernaturalstudio.com

Supernatural Studio Ltd.

Registered in England No. 10424679

VAT No. 473497452

Client:	Satila Studios
Project:	47 Great Marlborough Street
Drawing Title:	First Floor Plan - Option 1
Status:	Information
Date:	29/04/2025
Scale:	1:50@A1, 1:100@A3

Project:	Drawing Number:	Revision:
2406	00_101A	I03