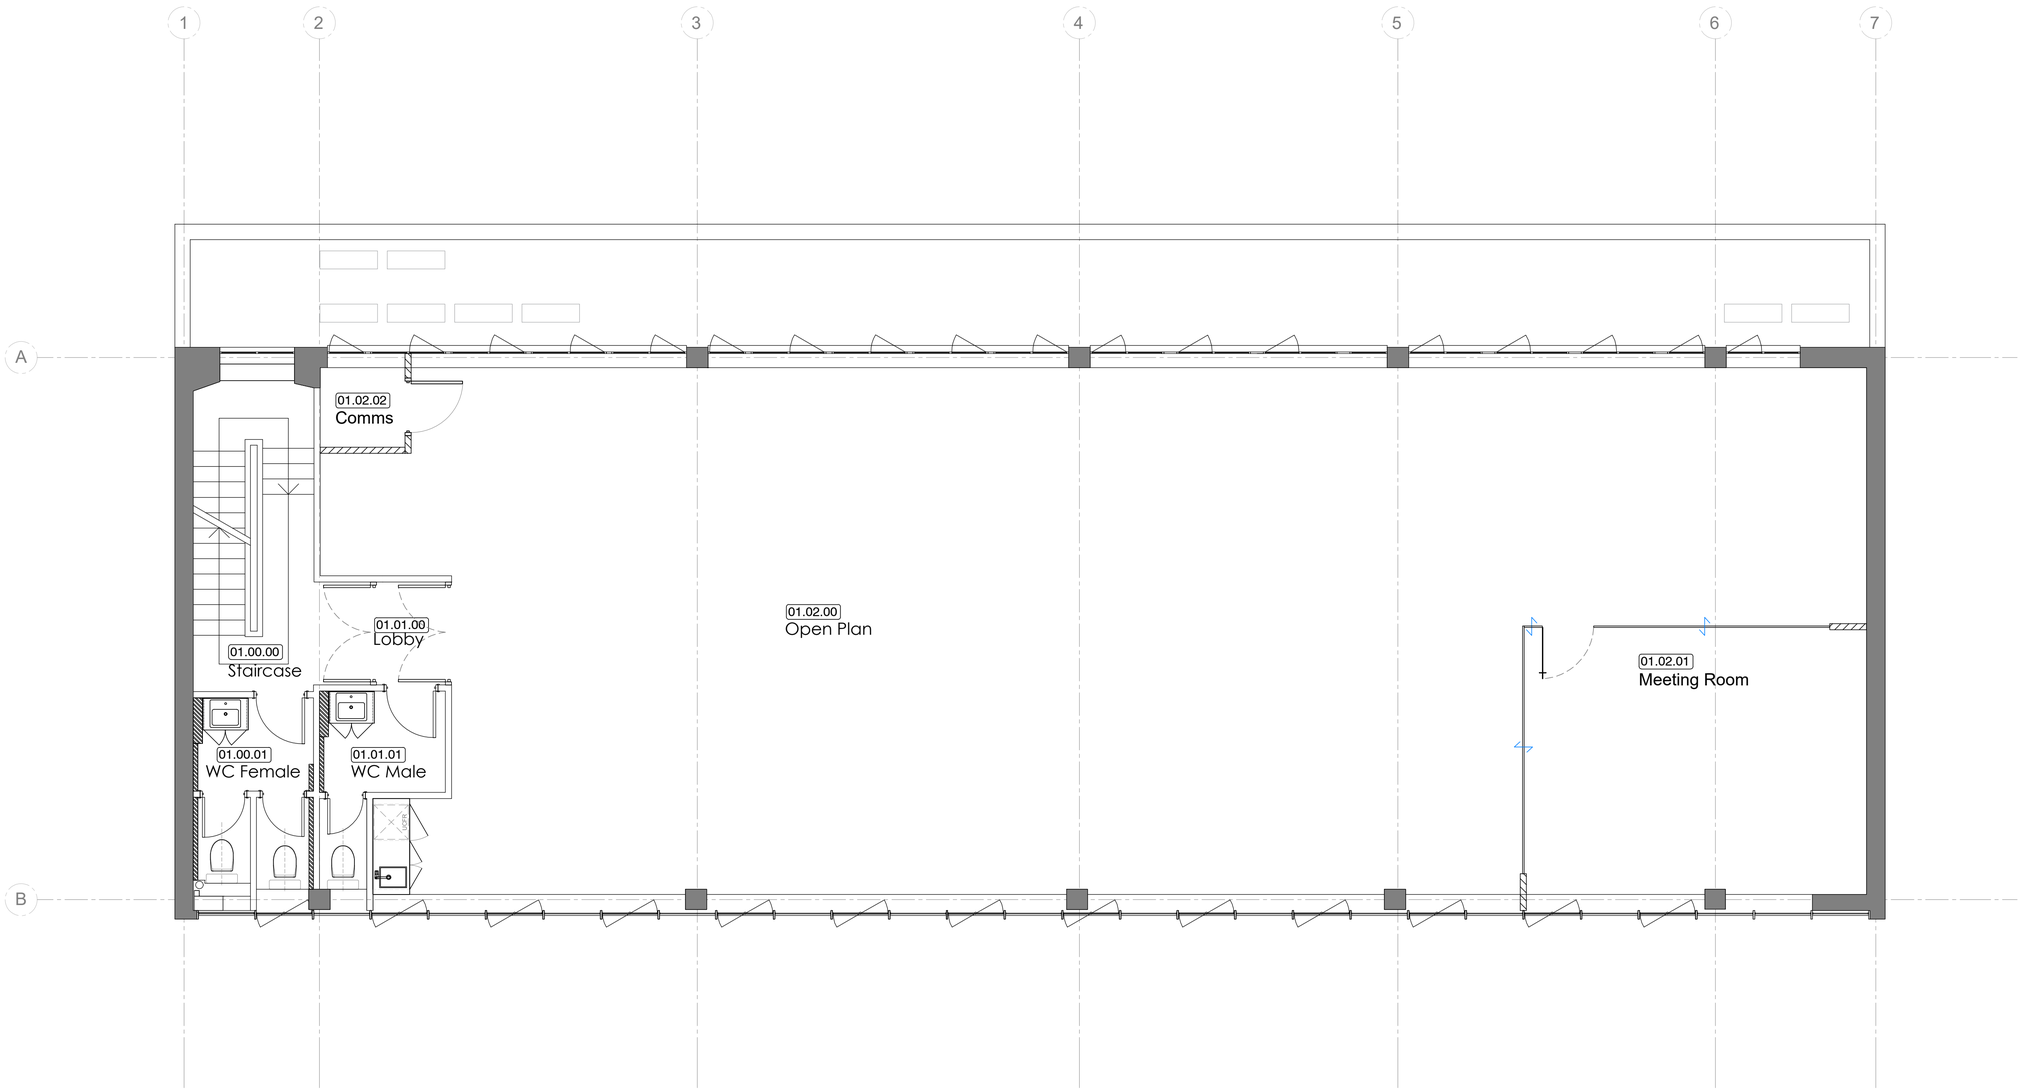


0 1 2 3 4 5

Scale Check in Meters

General Arrangement

- Existing Structural Wall
- No Works
- Existing Partition
- New Stud Partition
- Faux crittall mullions single glazed partition
- Existing Window
- Solid Door
- Glass Door
- MDF boxed wall
- 01.01.01 Room Number: First Floor - Office - Room 01

Notes

Rev	Description	By	Date
-	As-Built Issue	EM	2021.1.29

AS BUILT

imago interiors
+44 (0) 203 848 5199 // info@imago-interiors.com

This drawing is exclusive Copyright of Imago Interiors Ltd and may not be copied or handed to any third party without prior consent. All dimensions must be checked on site and not scaled from the drawing. All drawings and proposals are subject to approvals by statuary authorities.


Client:
Vitcorp Ltd

Site Address:
66 Wilton Road
London
SW1V 1DE

Drawing Title:
General Arrangement

Level:	Scale:
FIRST FLOOR	1:50 @A1
Drawn by:	Date:
MM	2021.1.29
Checked by:	Revision:
EM	/

Drawing No:
0350_01_GA_20_AB

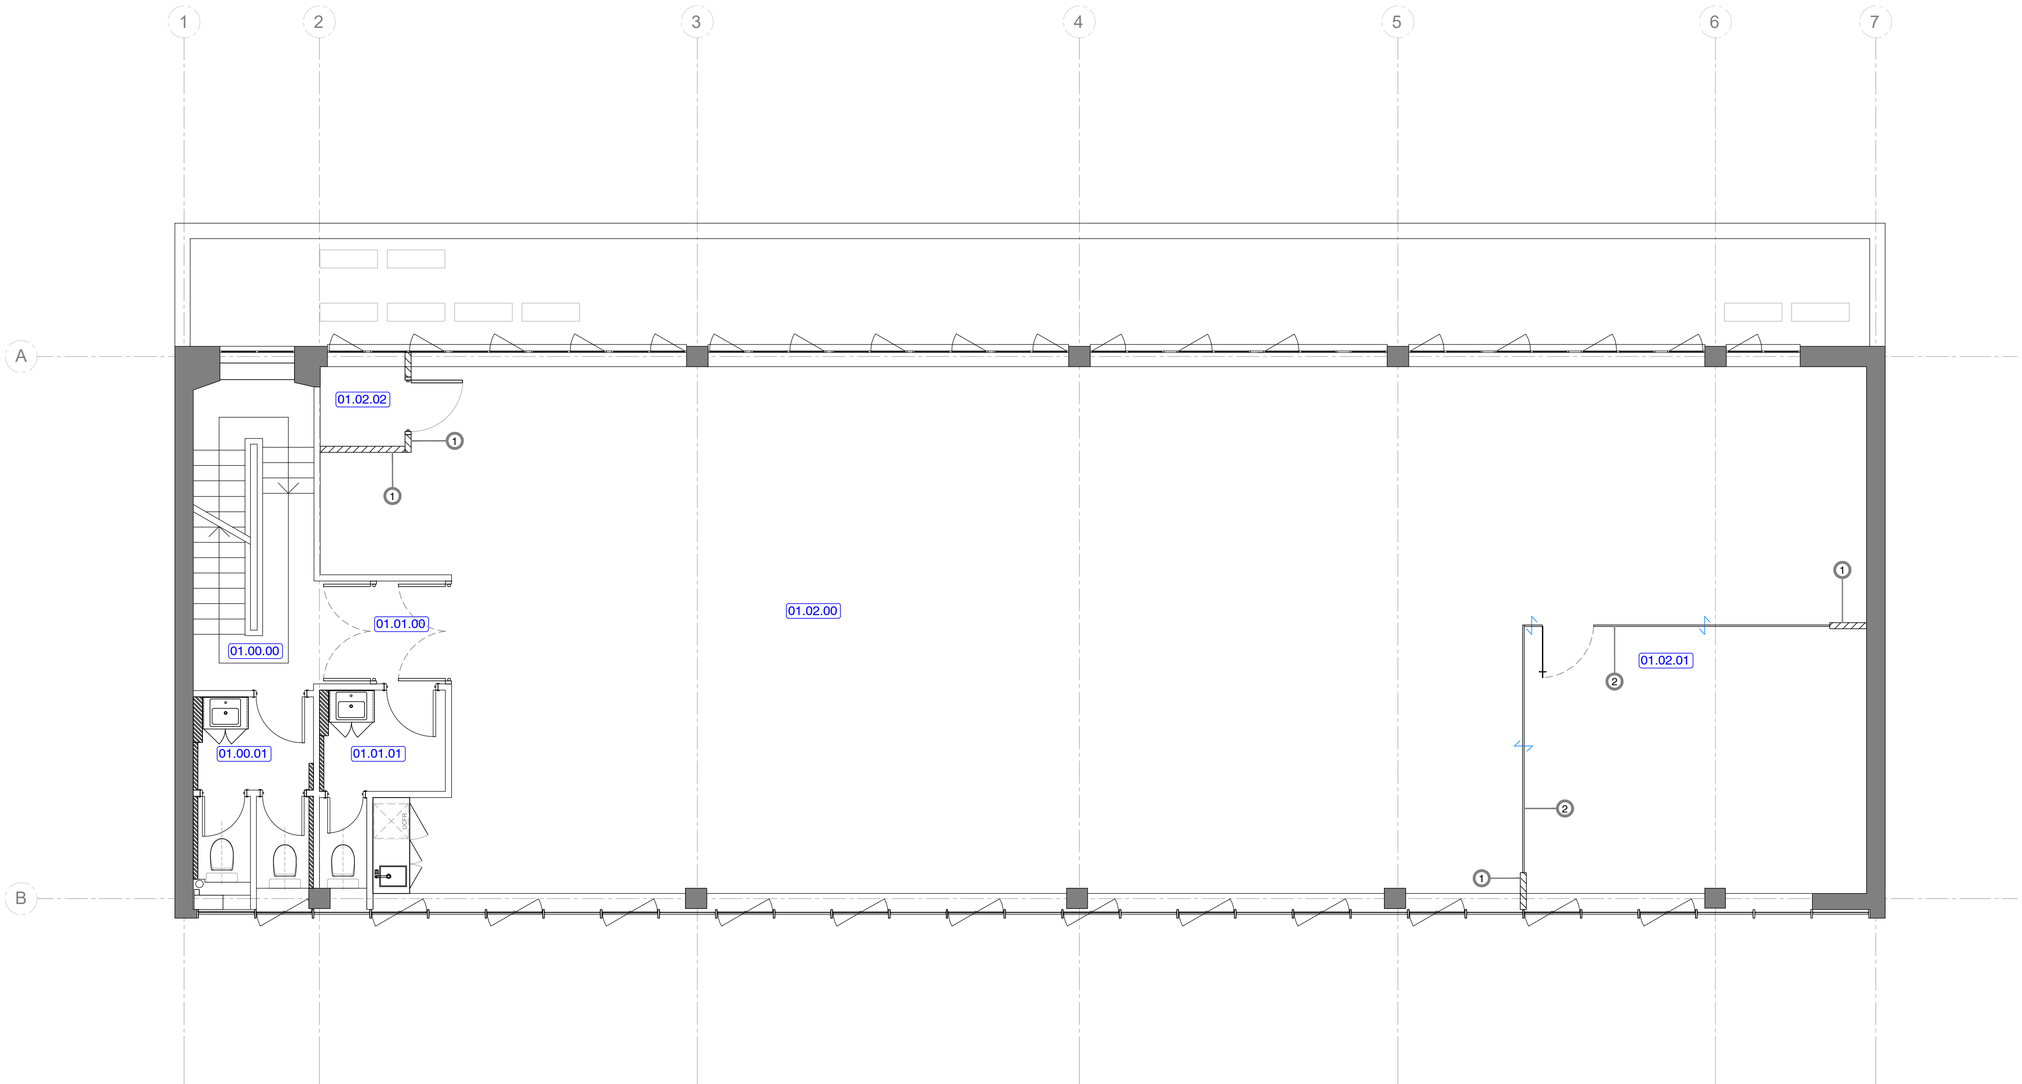

0 1 2 3 4 5

Scale Check in Meters

General Arrangement

- Existing Structural Wall
- No Works
- Existing Partition
- New Stud Partition
- Faux crittall mullions single glazed partition
- Existing Window
- Solid Door
- Glass Door
- MDF boxed wall
- 01.01.01 Room Number: First Floor - Office - Room 01

Partition Types

100 mm (1) 50mm stud with two sheets of 12.5mm plasterboard either side + 50 mm acoustic quilt within void

100mm (2) Faux crittall mullions single glazed partition
10mm toughened single glazed glass partition to run from finished floor level and door height, complete with dry joints, Aluminium head, base and side track - Track colour : RAL 9011
50mm stud with two sheets of 12.5mm plasterboard either side as a bulkhead to run from door height and Ceiling height

Notes

Rev	Description	By	Date
-	As-Built Issue	EM	2021.1.29

AS BUILT

imago interiors
+44 (0) 203 848 5199 // info@imago-interiors.com

This drawing is exclusive Copyright of Imago Interiors Ltd and may not be copied or handed to any third party without prior consent. All dimensions must be checked on site and not scaled from the drawing. All drawings and proposals are subject to approvals by statutory authorities.

Client:
Vitcorp Ltd


Site Address:
66 Wilton Road
London
SW1V 1DE

Drawing Title:
Partitioning

Level: FIRST FLOOR
Scale: 1:50 @A1
Drawn by: MM
Date: 2021.1.29
Checked by: EM
Revision: /
Drawing No: 0350_01_GA_21_AB

Small Power and Electrical

- Socket outlet - twin socket
  Relocating exiting outlet
- fused spur
- Distribution Board
- floor box (XP XD)
  Existing floor boxes to be removed
- Intercom (Audio Keypad)
- Keypad access
- Existing skirting trunking - new lid
  Galvanized finish

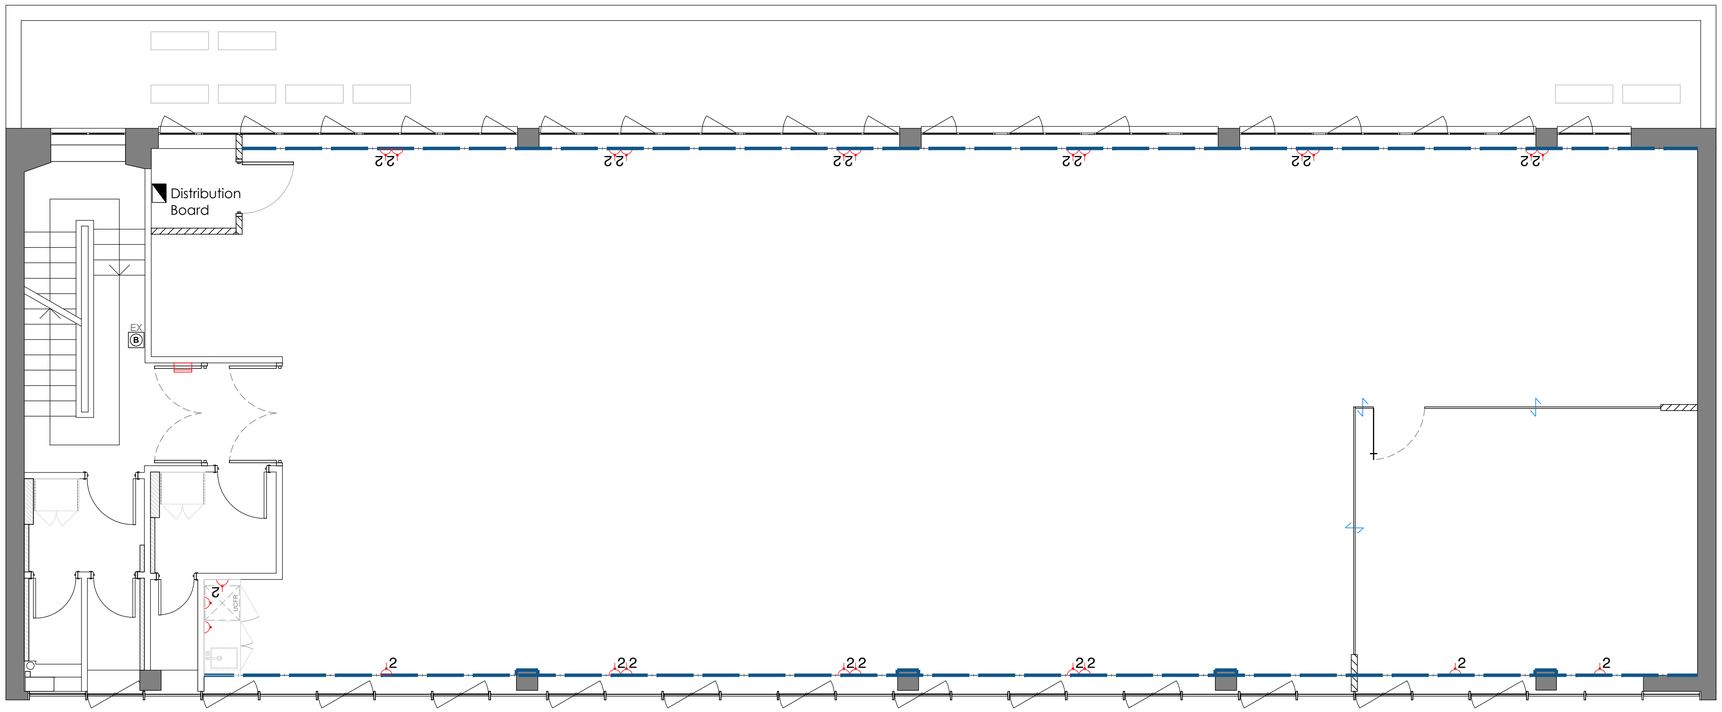

0 1 2 3 4 5

Scale Check in Meters

Rev	Description	By	Date
-	As-Built Issue	EM	2021.1.29

imago interiors
+44 (0) 203 848 5199 // info@imago-interiors.com

This drawing is exclusive Copyright of Imago Interiors Ltd and may not be copied or handed to any third party without prior consent. All dimensions must be checked on site and not scaled from the drawing. All drawings and proposals are subject to approvals by statutory authorities.

Client:

Vitcorp Ltd

Site Address:
66 Wilton Road
London
SW1V 1DE

Drawing Title:


Small power and electrical

Level:	Scale:
FIRST FLOOR	1:50 @A1
Drawn by:	Date:
MM	2021.1.29
Checked by:	Revision:
EM	/

Drawing No:

0350_01_RF_40_AB

AS BUILT

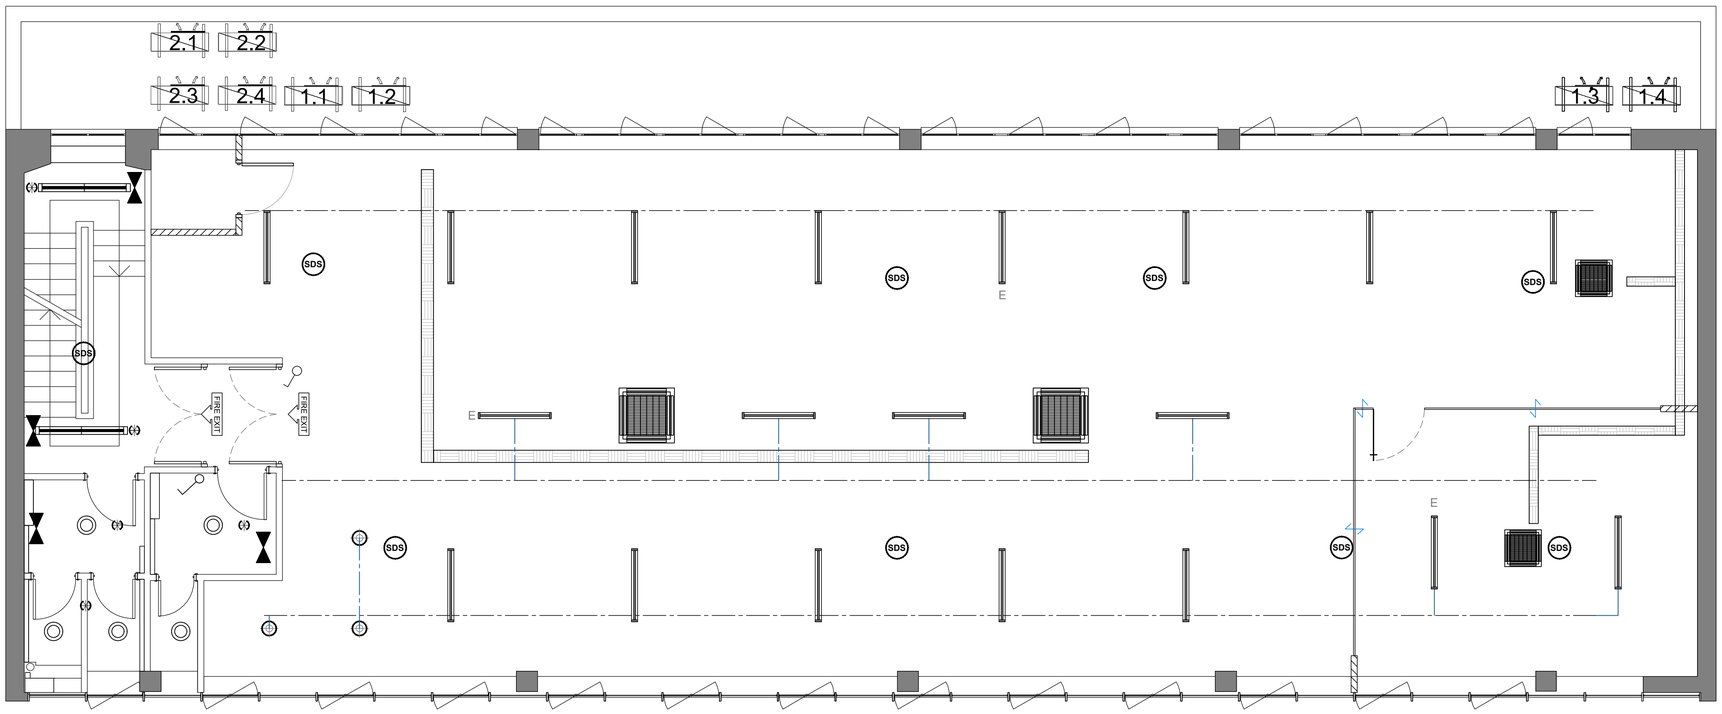

0 1 2 3 4 5

Scale Check in Meters

Ceiling and Lighting

plasterboard ceiling

Plasterboard Cut out 90mm up

L1 / E — New pendant light
V-TAC Slin linear light
1193x35x67mm
40 watts 3200 Lumens
Black finish

L2 / E — New ceiling mounted light
Aluminium Quarts
50 watts IP20
80mm diameter x 110mm

existing PIR

existing conduit

existing

existing motion detector

light switch

Existing AC unit -
AC grills to be Spray painted in RAL7024

SDS smoke detector

HDS Heat detector

AC AC Control switch

FIRE EXIT Illuminated Fire Exit signs

LIGHT/CEILING EQUIPMENT
BLANK = EXISTING N = NEW R = RELOCATED
=EMERGENCY

CEILING HEIGHT: 2560mm

Notes

Rev	Description	By	Date
-	As-Built Issue	EM	2021.1.29

imago interiors
+44 (0) 203 848 5199 // info@imago-interiors.com

This drawing is exclusive Copyright of Imago Interiors Ltd and may not be copied or handed to any third party without prior consent. All dimensions must be checked on site and not scaled from the drawing. All drawings and proposals are subject to approvals by statutory authorities.

Client:

Vitcorp Ltd

Site Address:
66 Wilton Road
London
SW1V 1DE

Drawing Title:

Reflected Ceiling

Level:	Scale:
FIRST FLOOR	1:50 @A1
Drawn by:	Date:
MM	2021.1.29
Checked by:	Revision:
EM	/

Drawing No:


0350_01_RC_50_AB

AS BUILT

Joinery Schedule

Joinery Item

Type # — Joinery Number

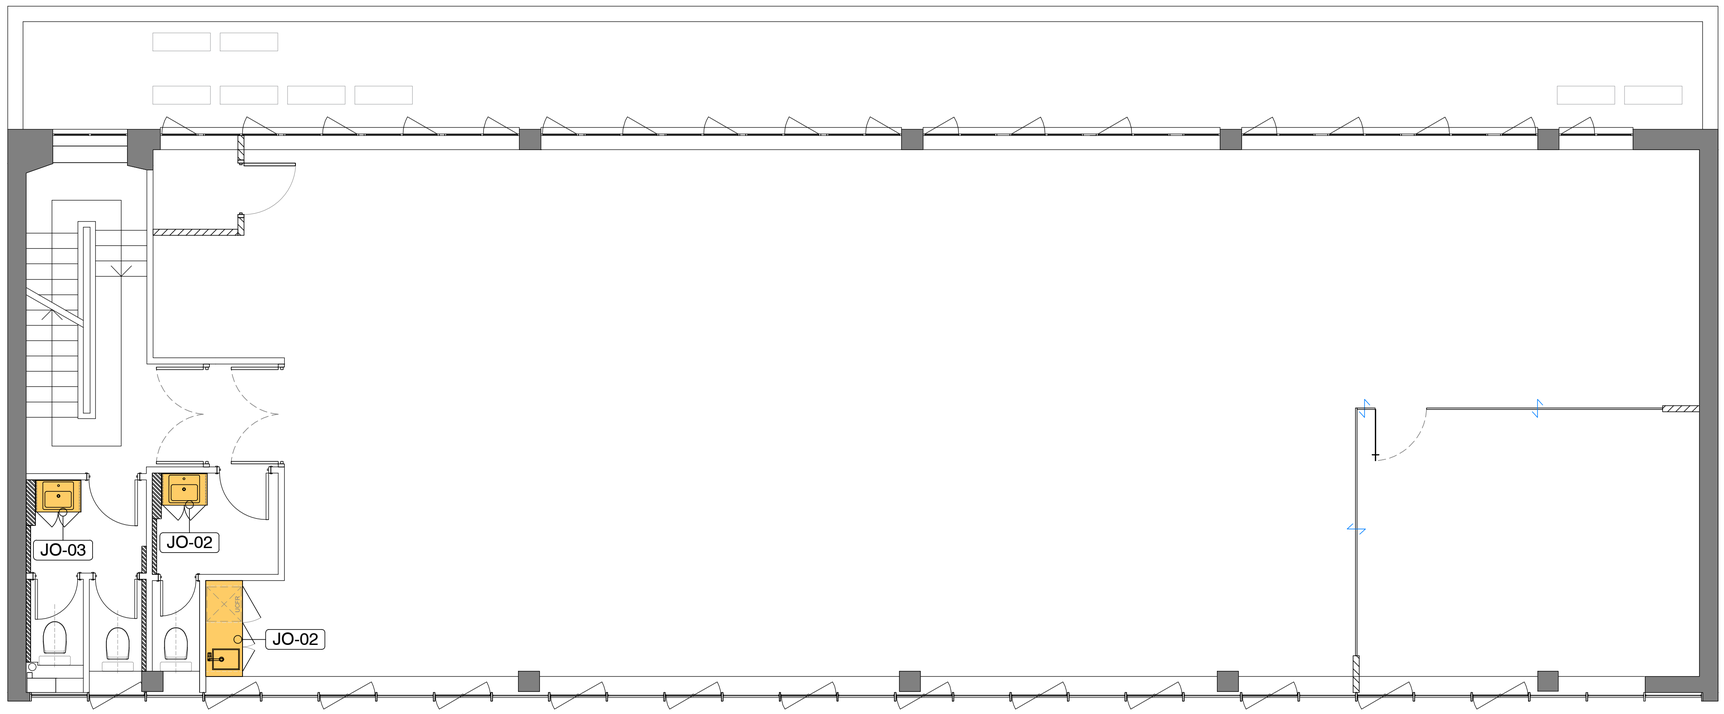

Notes

Rev	Description	By	Date
-	As-Built Issue	EM	2021.1.29

imago interiors
+44 (0) 203 848 5199 // info@imago-interiors.com

This drawing is exclusive Copyright of Imago Interiors Ltd and may not be copied or handed to any third party without prior consent. All dimensions must be checked on site and not scaled from the drawing. All drawings and proposals are subject to approvals by statutory authorities.

Client:
Vitcorp Ltd


Site Address:
66 Wilton Road
London
SW1V 1DE


Drawing Title:
Joinery Schedule

Level:	Scale:
FIRST FLOOR	1:50 @A1
Drawn by:	Date:
MM	2021.1.29
Checked by:	Revision:
EM	/

Drawing No:
0350_01_JS_60_AB


AS BUILT

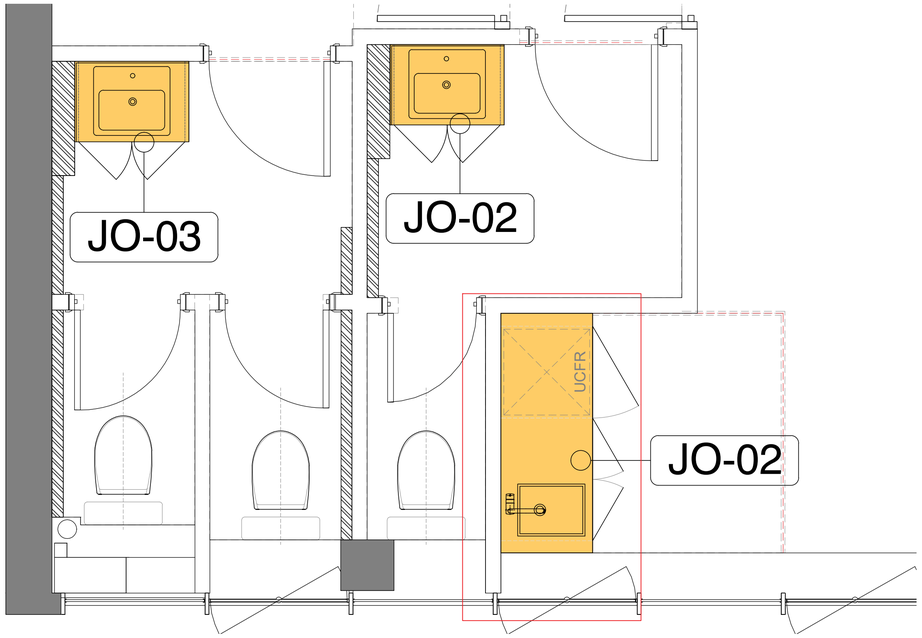

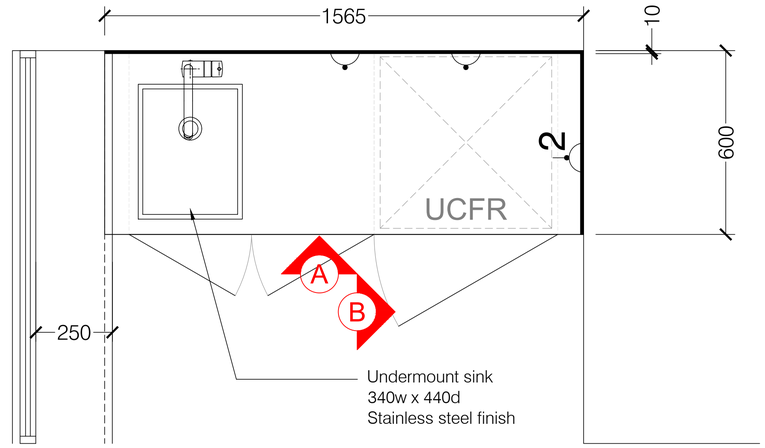


- JO.01 Tea point PLAN

Scale 1:10@A1 / 1:20@A3

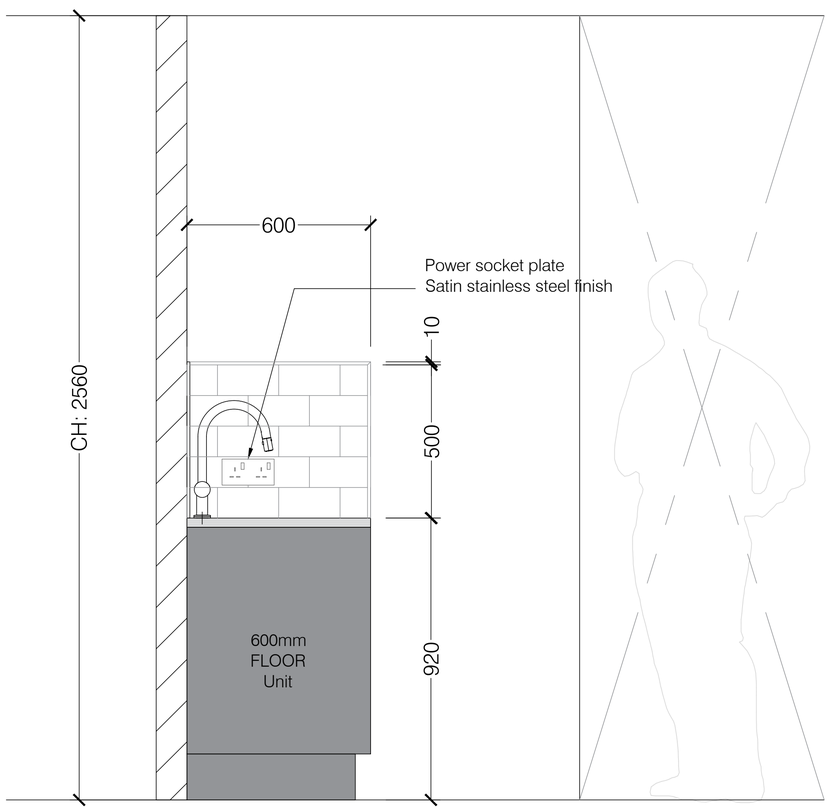

B JO.01 Tea point ELEVATION

Scale 1:10 @ A1 / 1:20 @ A3

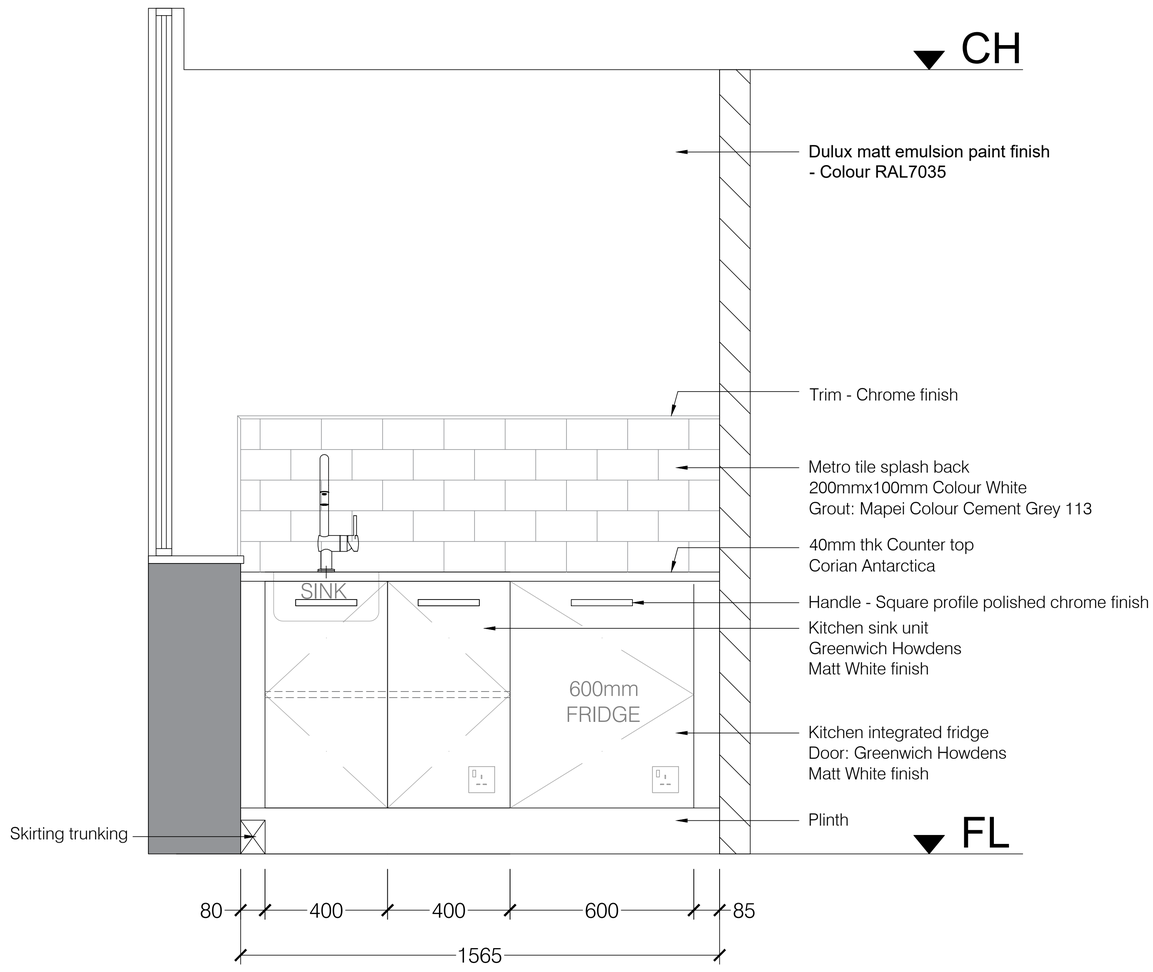

A JO.01 Tea point ELEVATION

Scale 1:10 @ A1 / 1:20 @ A3

Details and Elevations

- Centre Line
- ELEVATION (A, Scale 1:10)
- Elevation
- Section
- Detail call-out

Notes

Rev	Description	By	Date
-	As-Built Issue	EM	2021.1.29

imago interiors
+44 (0) 203 848 5199 // info@imago-interiors.com

This drawing is exclusive Copyright of Imago Interiors Ltd and may not be copied or handed to any third party without prior consent. All dimensions must be checked on site and not scaled from the drawing. All drawings and proposals are subject to approvals by statuary authorities.

Client:
Vitcorp Ltd


Site Address:
66 Wilton Road
London
SW1V 1DE


Drawing Title:
Joinery Detail : JO_01 : Tea point

Level: FIRST FLOOR
Scale: Various @A1
Drawn by: MM
Date: 2021.1.29
Checked by: EM
Revision: /

Drawing No:
0350_01_DT_61_AB

AS BUILT

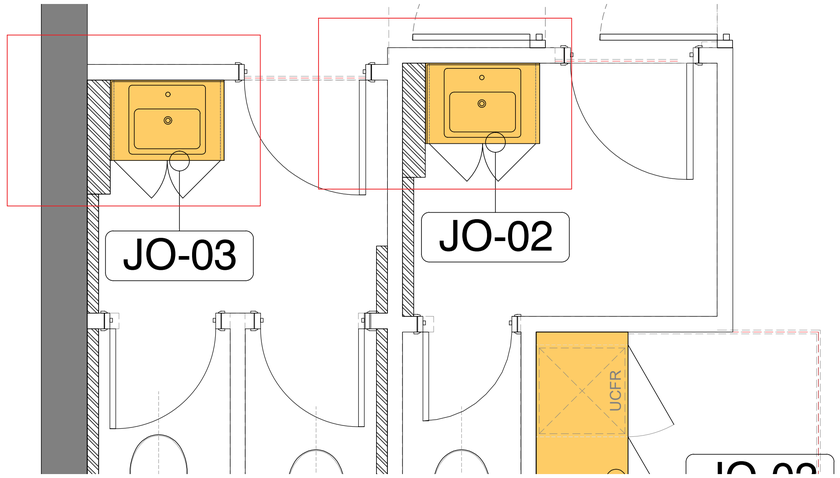


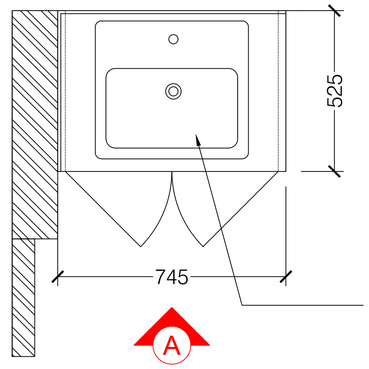

Worktop inset square basin
500mm x 450mm
Vitra S20

- JO.02&03 Vanity unit PLAN

Scale 1:10@A1 / 1:20@A3

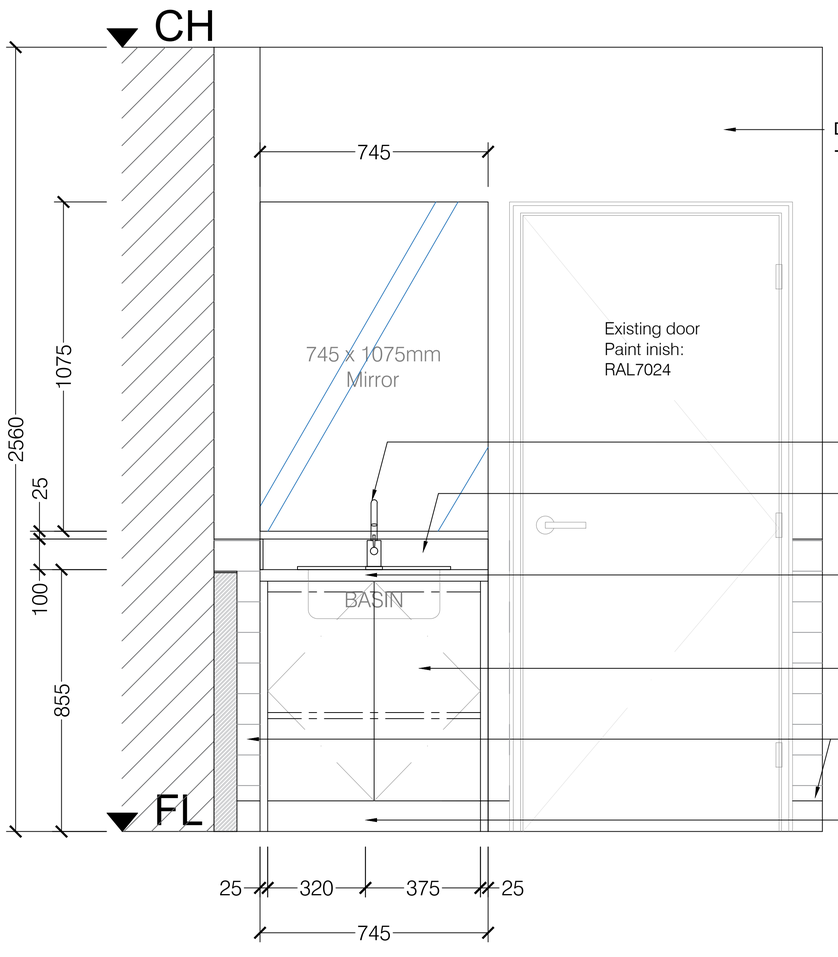

Dulux matt emulsion paint finish
- Colour RAL7035

Basin Tap
Grohe polished chrome finish

10mm thk Upstand
Corian Antarctica

Worktop 40mm thk
Corian Antarctica


Vanity unit
Joinery MFC carcus
Catch & release doors

Wall: Metro tile
200mmx100mm Colour White
Grout: Mapei Colour
Cement Grey 113

Skirting
Eggshell paint pure brilliant white

A JO.03 Vanity unit (Female) ELEVATION

Scale 1:10 @ A1 / 1:20 @ A3

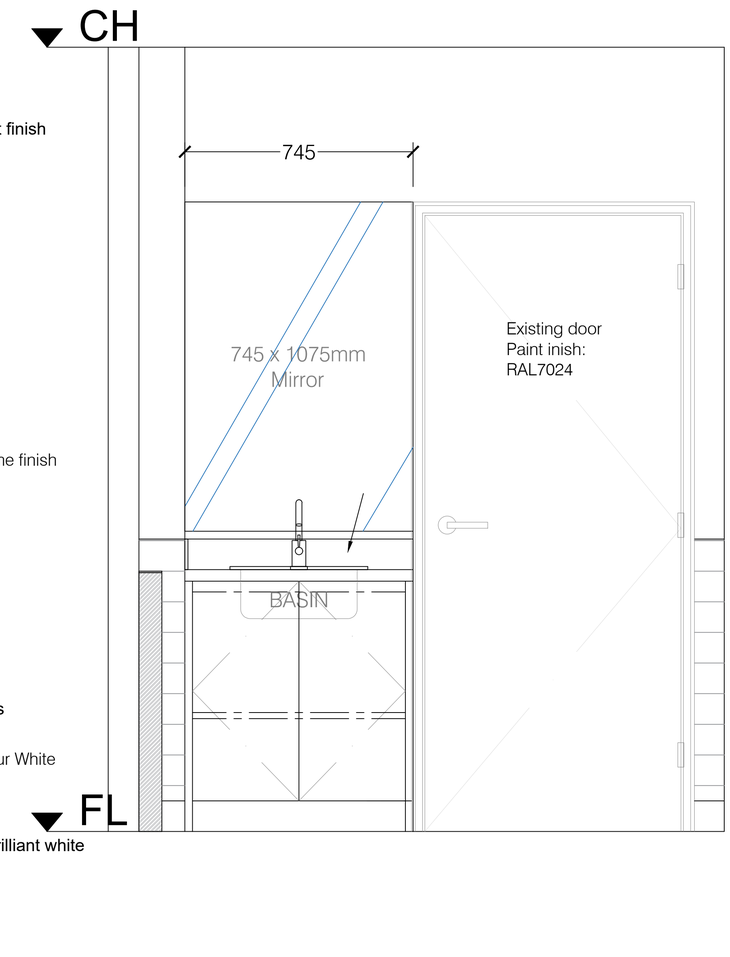

A JO.02 Vanity unit (Male) ELEVATION

Scale 1:10 @ A1 / 1:20 @ A3

AS BUILT

Details and Elevations

- Centre Line
- ELEVATION
- Elevation
- Section
- Detail call-out

Notes

Rev	Description	By	Date
-	As-Built Issue	EM	2021.1.29

imago interiors
+44 (0) 203 848 5199 // info@imago-interiors.com

This drawing is exclusive Copyright of Imago Interiors Ltd and may not be copied or handed to any third party without prior consent. All dimensions must be checked on site and not scaled from the drawing. All drawings and proposals are subject to approvals by statutory authorities.


Client:
Vitcorp Ltd

Site Address:
66 Wilton Road
London
SW1V 1DE

Drawing Title:
Joinery Detail : JO_02&03 : Vanity Unit

Level:	Scale:
FIRST FLOOR	Various @A1
Drawn by:	Date:
MM	2021.1.29
Checked by:	Revision:
EM	/

Drawing No:
0350_01_DT_62_AB

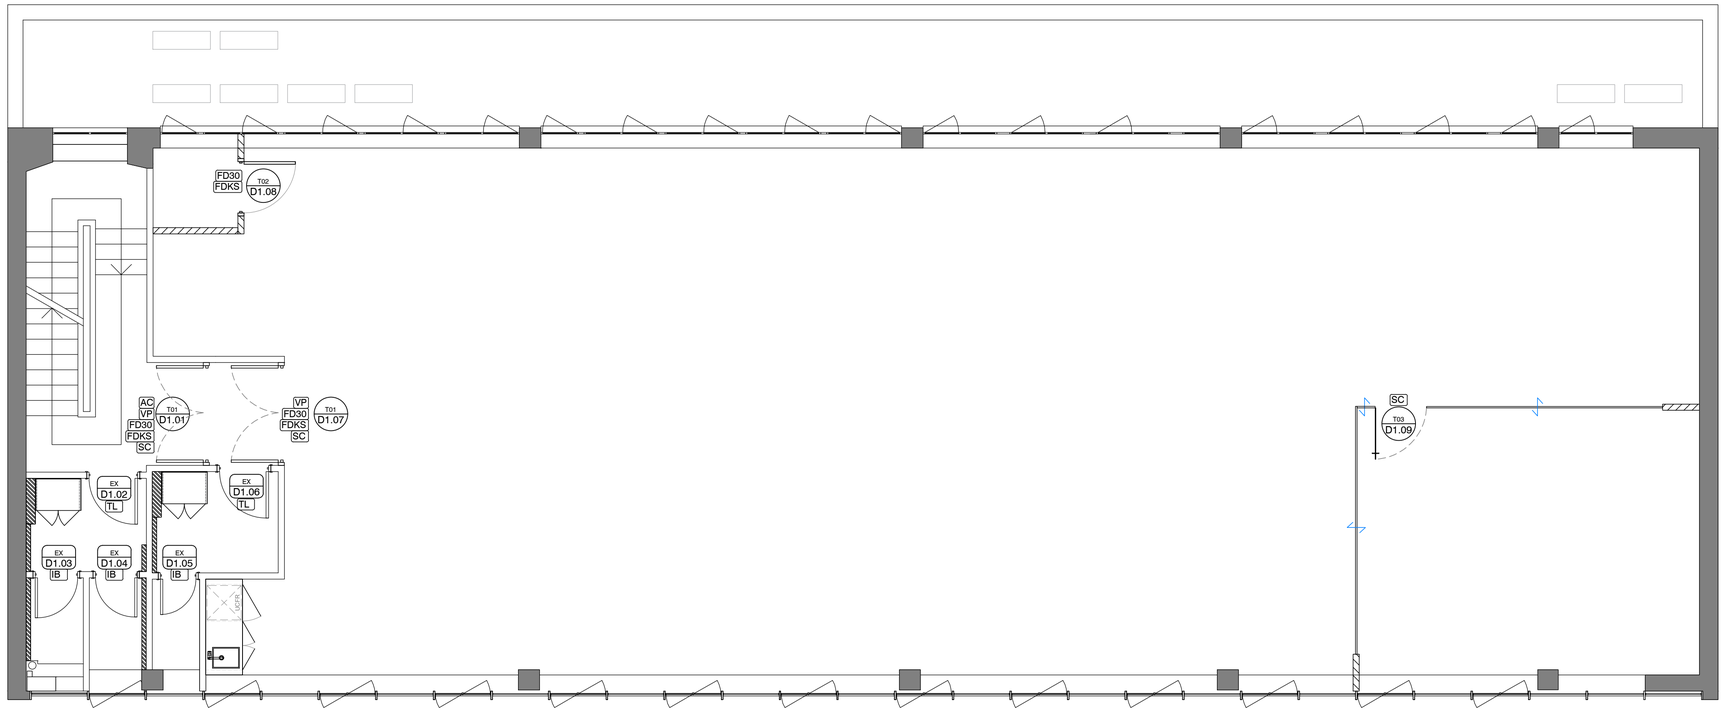

Door Schedule



TL D1.01
TL D1.07
New Door: Type 01
Double solid door
New set timber fire double door to match existing on 2nd floor
- with new Access Control



TL D1.08
New Door: Type 02
Single solid door



TL D1.09
New Door: Type 03
Glass door
With Faux crittall mullions




EX D01.5
Existing Door:
1st Floor - Remain as is
Repainted in Grey RAL7024

TL	Thumb Lock
VP	Vision panel
SC	Self closing
FD30	30min fire door
FD60	60min fire door
FDKS	"Fire door keep shut" sign on door
PB	Panic release push bar
AC	Access control
IB	Indicator bolt lock

Notes

Rev	Description	By	Date
-	As-Built Issue	EM	2021.1.29


Type 01

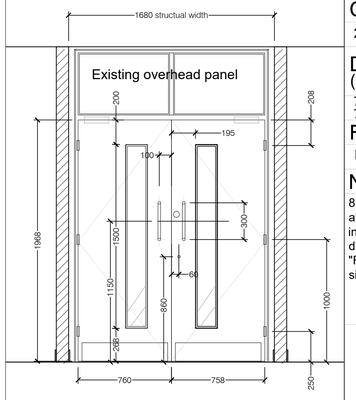

DOORS	1F: D1.01,D1.07
QUANTITY	2
DIMENSIONS (panel size)	760 x 1968mm 758 x 1968mm
FIRE RATING	FD30
NOTES	8mm under cut door to allow for flooring set inflame opening dimension, "Fire door keep close" sign x1

DOOR CLOSER	2no Self door closer	
VISION PANEL	150x1500, clear glass with flush bead + 3mm groove	
FINISHES	FACE SIDE	Painted in grey RAL7024
	REVERSE SIDE	Painted in grey RAL7024
	FRAME	Existing - Painted in white
IRONMONGERY	HINGES	6 no
	LOCKS	GEO Cylinder lock
	DOOR STOP	2 no
	HANDLES	2 no D handle 300mm
	OTHERS	2 no kick plate 750x150 (inside) 2no push plate 300x100 (inside)


Type 02

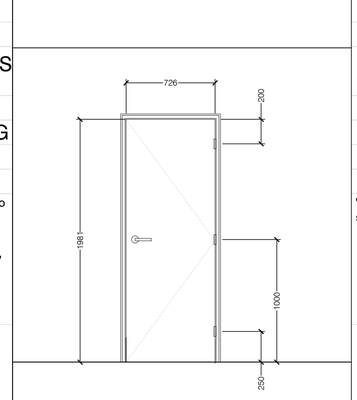

DOORS	1F: D1.08
QUANTITY	1
DIMENSIONS (panel size)	726 x 1981mm
FIRE RATING	FD30
NOTES	"Fire door keep close" sign x1

DOOR CLOSER	No	
VISION PANEL	No	
FINISHES	FACE SIDE	Painted in grey RAL7024
	REVERSE SIDE	Painted in grey RAL7024
	FRAME	Painted in white
IRONMONGERY	HINGES	3 no
	LOCKS	-
	DOOR STOP	1 no
	HANDLES	Lever handle
	OTHERS	

Type 03

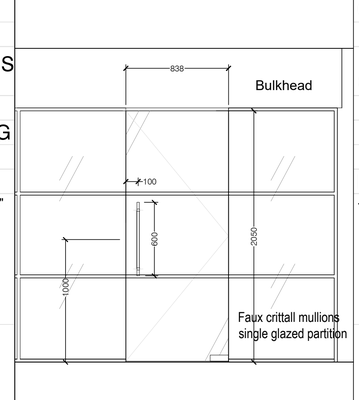

DOORS	1F: D1.09
QUANTITY	1
DIMENSIONS (panel size)	838 x 2050mm
FIRE RATING	none
NOTES	-

DOOR CLOSER	Floor spring closer	
VISION PANEL	No	
FINISHES	FACE SIDE	Clear Glass
	REVERSE SIDE	Clear Glass
	FRAME	Aluminium frame RAL9011
IRONMONGERY	HINGES	Hinge for frameless glass door
	LOCKS	-
	DOOR STOP	1 no
	HANDLES	T handle
	OTHERS	Faux crittall mullions Aluminium frame RAL9011

0 1 2 3 4 5
Scale Check in Meters

AS BUILT

imago interiors
+44 (0) 203 848 5199 // info@imago-interiors.com

This drawing is exclusive Copyright of Imago Interiors Ltd and may not be copied or handed to any third party without prior consent. All dimensions must be checked on site and not scaled from the drawing. All drawings and proposals are subject to approvals by statuary authorities.

Client:
Vitcorp Ltd

Site Address:
66 Wilton Road
London
SW1V 1DE

Drawing Title:
Door Schedule

Level: FIRST FLOOR
Scale: 1:50 @A1
Drawn by: MM
Date: 2021.1.29
Checked by: EM
Revision: /

Drawing No:
0350_01_DS_70_AB


Finishes

F1 FLOOR FINISH 1 - Existing parquet timber floor to be repaired

F2 FLOOR FINISH 2 - New vinyl Fl. LVT Milliken Loose Lay - Heritage Wood

FLOOR TRIM

UNTOUCHED AREA NO WORKS

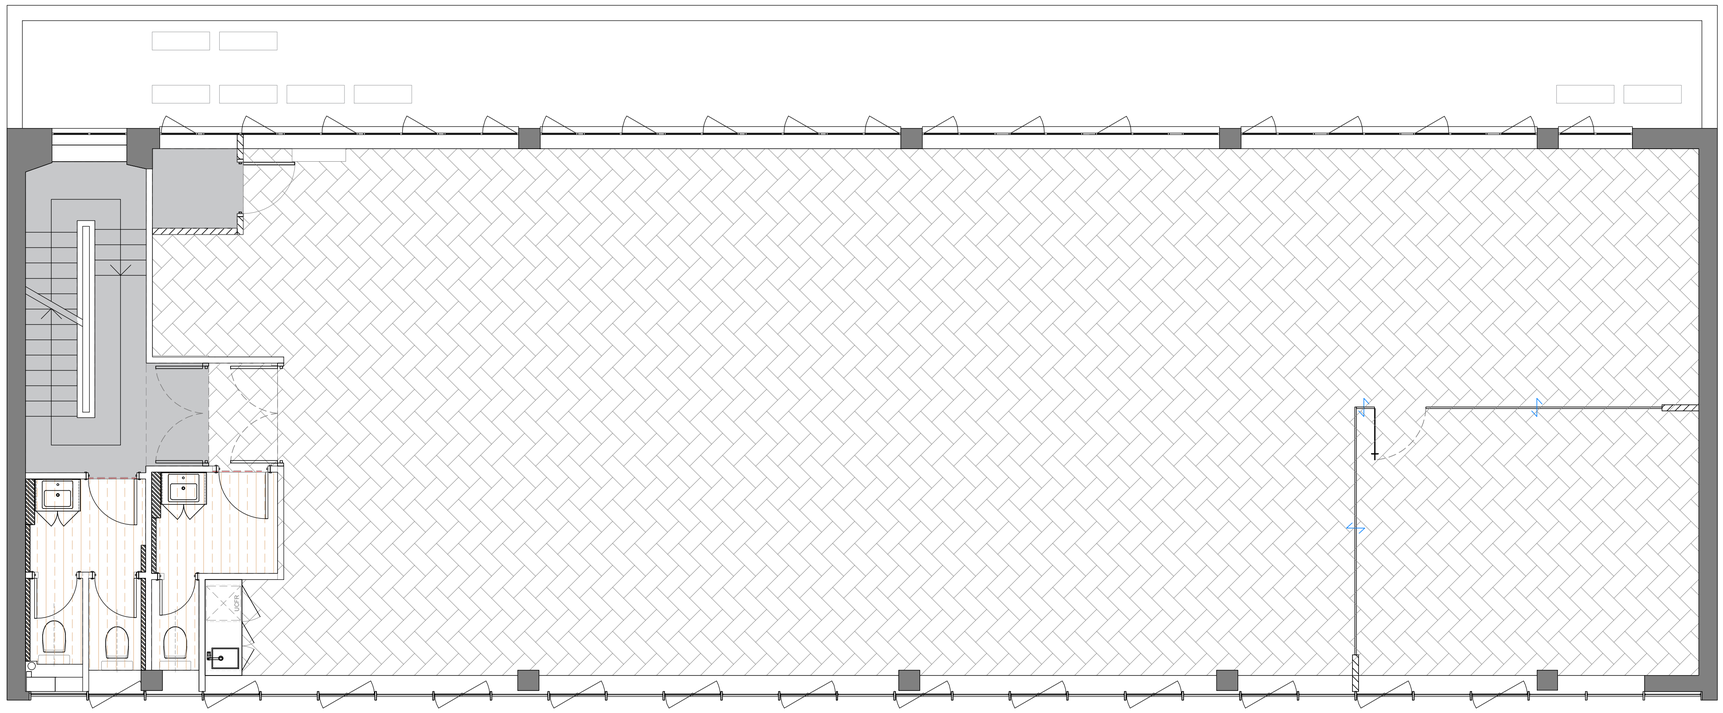

0 1 2 3 4 5

Scale Check in Meters

Rev	Description	By	Date
-	As-Built Issue	EM	2021.1.29

imago interiors
+44 (0) 203 848 5199 // info@imago-interiors.com

This drawing is exclusive Copyright of Imago Interiors Ltd and may not be copied or handed to any third party without prior consent. All dimensions must be checked on site and not scaled from the drawing. All drawings and proposals are subject to approvals by statutory authorities.

Client:
Vitcorp Ltd

Site Address:
66 Wilton Road
London
SW1V 1DE

Drawing Title:
Finishes Schedule - Floor


Level:	Scale:
FIRST FLOOR	1:50 @A1
Drawn by:	Date:
MM	2021.1.29
Checked by:	Revision:
EM	/

Drawing No:
0350_01_FS_85_AB

AS BUILT

Finishes

- Paint A — Type A: 2no coats of Dulux matt emulsion paint finish - RAL7035
- Paint B — Type B: Window sill / Skirting Eggshell paint finish - Pure Brilliant White
- Paint C — Type C: Toilet 2no coats of Dulux matt emulsion paint finish - RAL7035
- Tile D — Type D: Metro tile HR JOHNSON PRG1 WHITE 100x200, Install Brickbond MAPEI Grout 113
- Spray Paint E — Type E: Existing External Windows (Inside only) Spray paint finish - Graphite
- Blind F — Type F: External Windows Roller blinds - Shale Grey

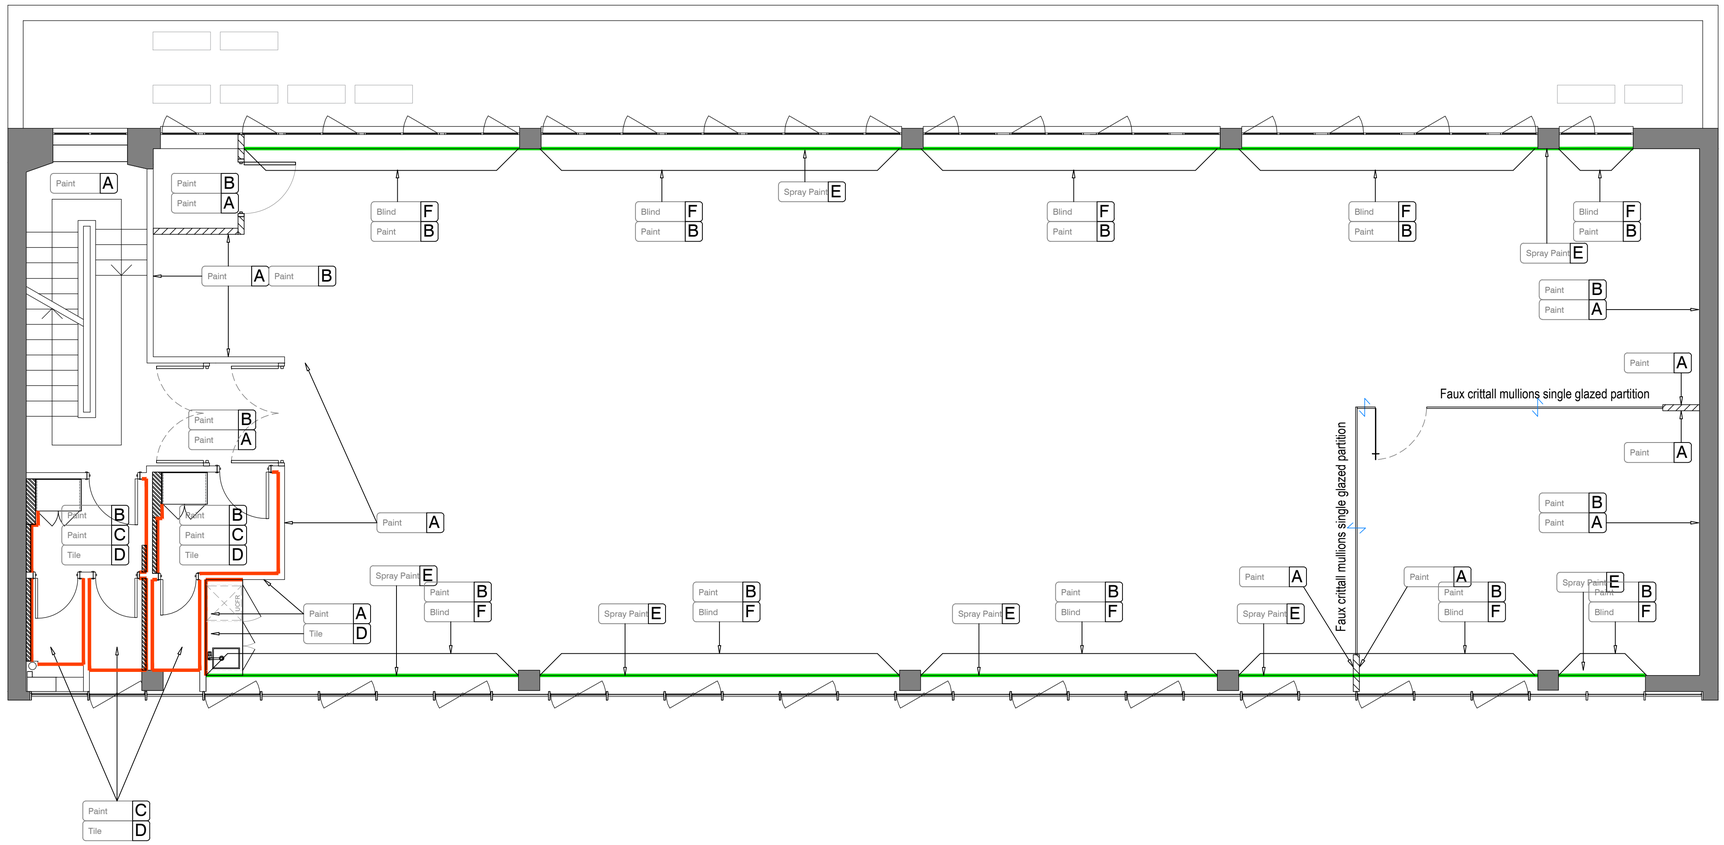

0 1 2 3 4 5

Scale Check in Meters

Notes

Rev	Description	By	Date
-	As-Built Issue	EM	2021.1.29

imago interiors
+44 (0) 203 848 5199 // info@imago-interiors.com

This drawing is exclusive Copyright of Imago Interiors Ltd and may not be copied or handed to any third party without prior consent. All dimensions must be checked on site and not scaled from the drawing. All drawings and proposals are subject to approvals by statutory authorities.

Client:
Vitcorp Ltd


Site Address:
66 Wilton Road
London
SW1V 1DE

Drawing Title:
Finishes Schedule - Wall

Level: FIRST FLOOR
Scale: 1:50 @A1
Drawn by: MM
Date: 2021.1.29
Checked by: EM
Revision: /
Drawing No: 0350_01_FS_86_AB

AS BUILT

Existing MF ceiling and bulkhead
paint finish:
Dulux pure brilliant white matt

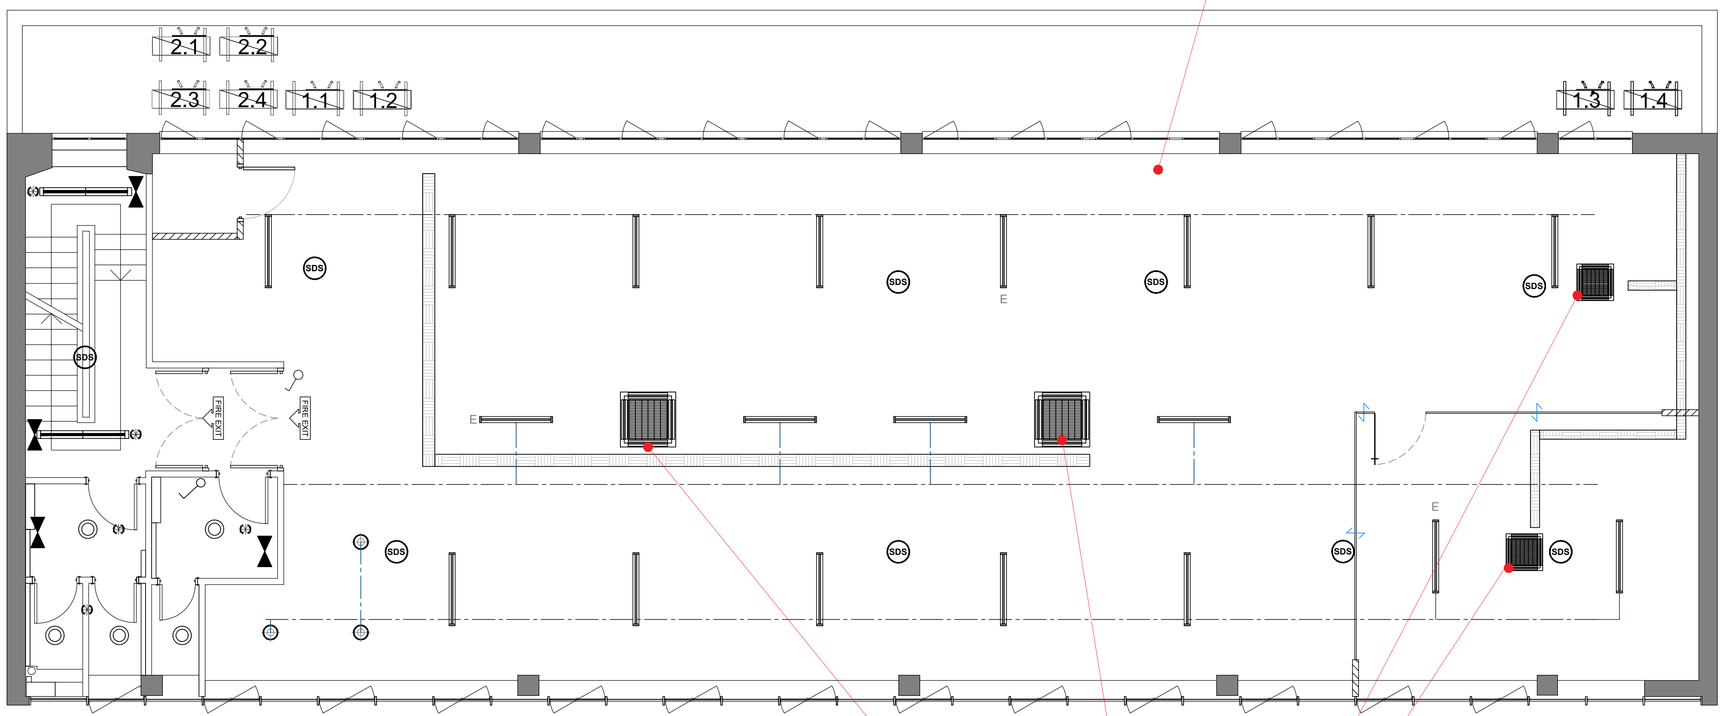

Existing AC grill to be painted black
RAL7024

Notes

Rev	Description	By	Date
-	As-Built Issue	EM	2021.1.29

imago interiors
+44 (0) 203 848 5199 // info@imago-interiors.com

This drawing is exclusive Copyright of Imago Interiors Ltd and may not be copied or handed to any third party without prior consent. All dimensions must be checked on site and not scaled from the drawing. All drawings and proposals are subject to approvals by statutory authorities.

Client:
Vitcorp Ltd

Site Address:
66 Wilton Road
London
SW1V 1DE

Drawing Title:
Finishes Schedule - Ceiling

Level:	Scale:
FIRST FLOOR	1:50 @A1
Drawn by:	Date:
MM	2021.1.29
Checked by:	Revision:
EM	/

Drawing No:
0350_01_FS_87_AB

AS BUILT